NE 2 28 23

FROM THE OFFICE OF

CHARLES O. GEORGI COMPANY

2215 West County Road B Saint Paul, Minnesota 55113

REGISTERED CIVIL ENGINEER AND LAND SURVEYOR

Certificate of Survey

Project No. Minn. A-1-1
Parcel No. 108-C
Area: 5635 Sq.ft., m.o.l

I Hereby Certify that **this plat shows a survey made by me of the property described on this plat, and that the corners are correctly placed as shown, and that all locations have been correctly shown.**

Surveyed For Housing Authority

Date May 1976

Scale 1"=40'

By .....
REGISTERED LAND SURVEYOR

Description:

Lot 14 and the Easterly 20.0 feet of Lot 17, Block 2, Holcombe's Addition to St. Paul.
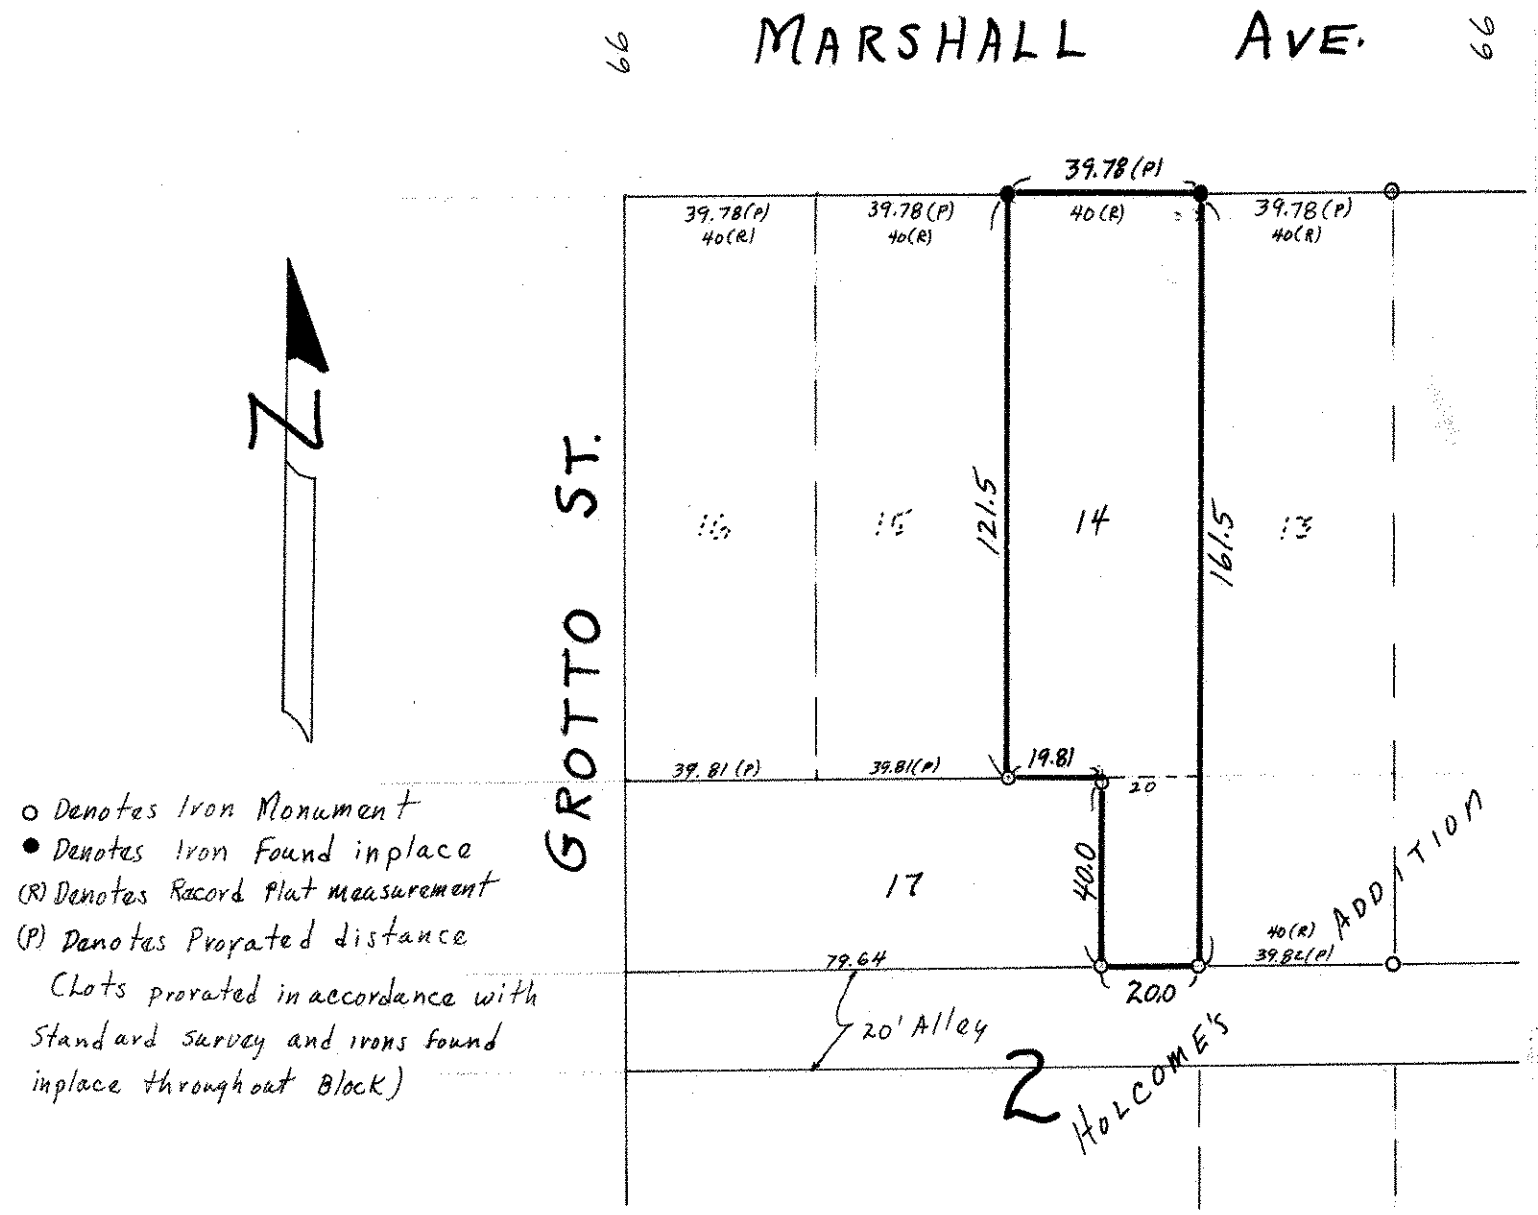
Ramsey County, Minn.