NE 6 2822

Sheet #1

Certificate of Survey

FROM THE OFFICE OF

CHARLES O. GEORGI COMPANY

2215 West County Road B — Saint Paul, Minnesota 55113

REGISTERED CIVIL ENGINEER AND LAND SURVEYOR

I Hereby Certify that **this plat shows a location survey made by me of the property described on this plat, and that the corners are correctly placed as shown, and that all locations have been correctly shown.**

4/77 See Sheet #2

Footbridge between Degree of Honor Bldg. & Minn. Mutual Bldg. across 4th St.

* See Sheet #2

Surveyed For Housing Authority

Date August 1976

Scale 1" = 20'

By Charles O. Georgi
REGISTERED LAND SURVEYOR

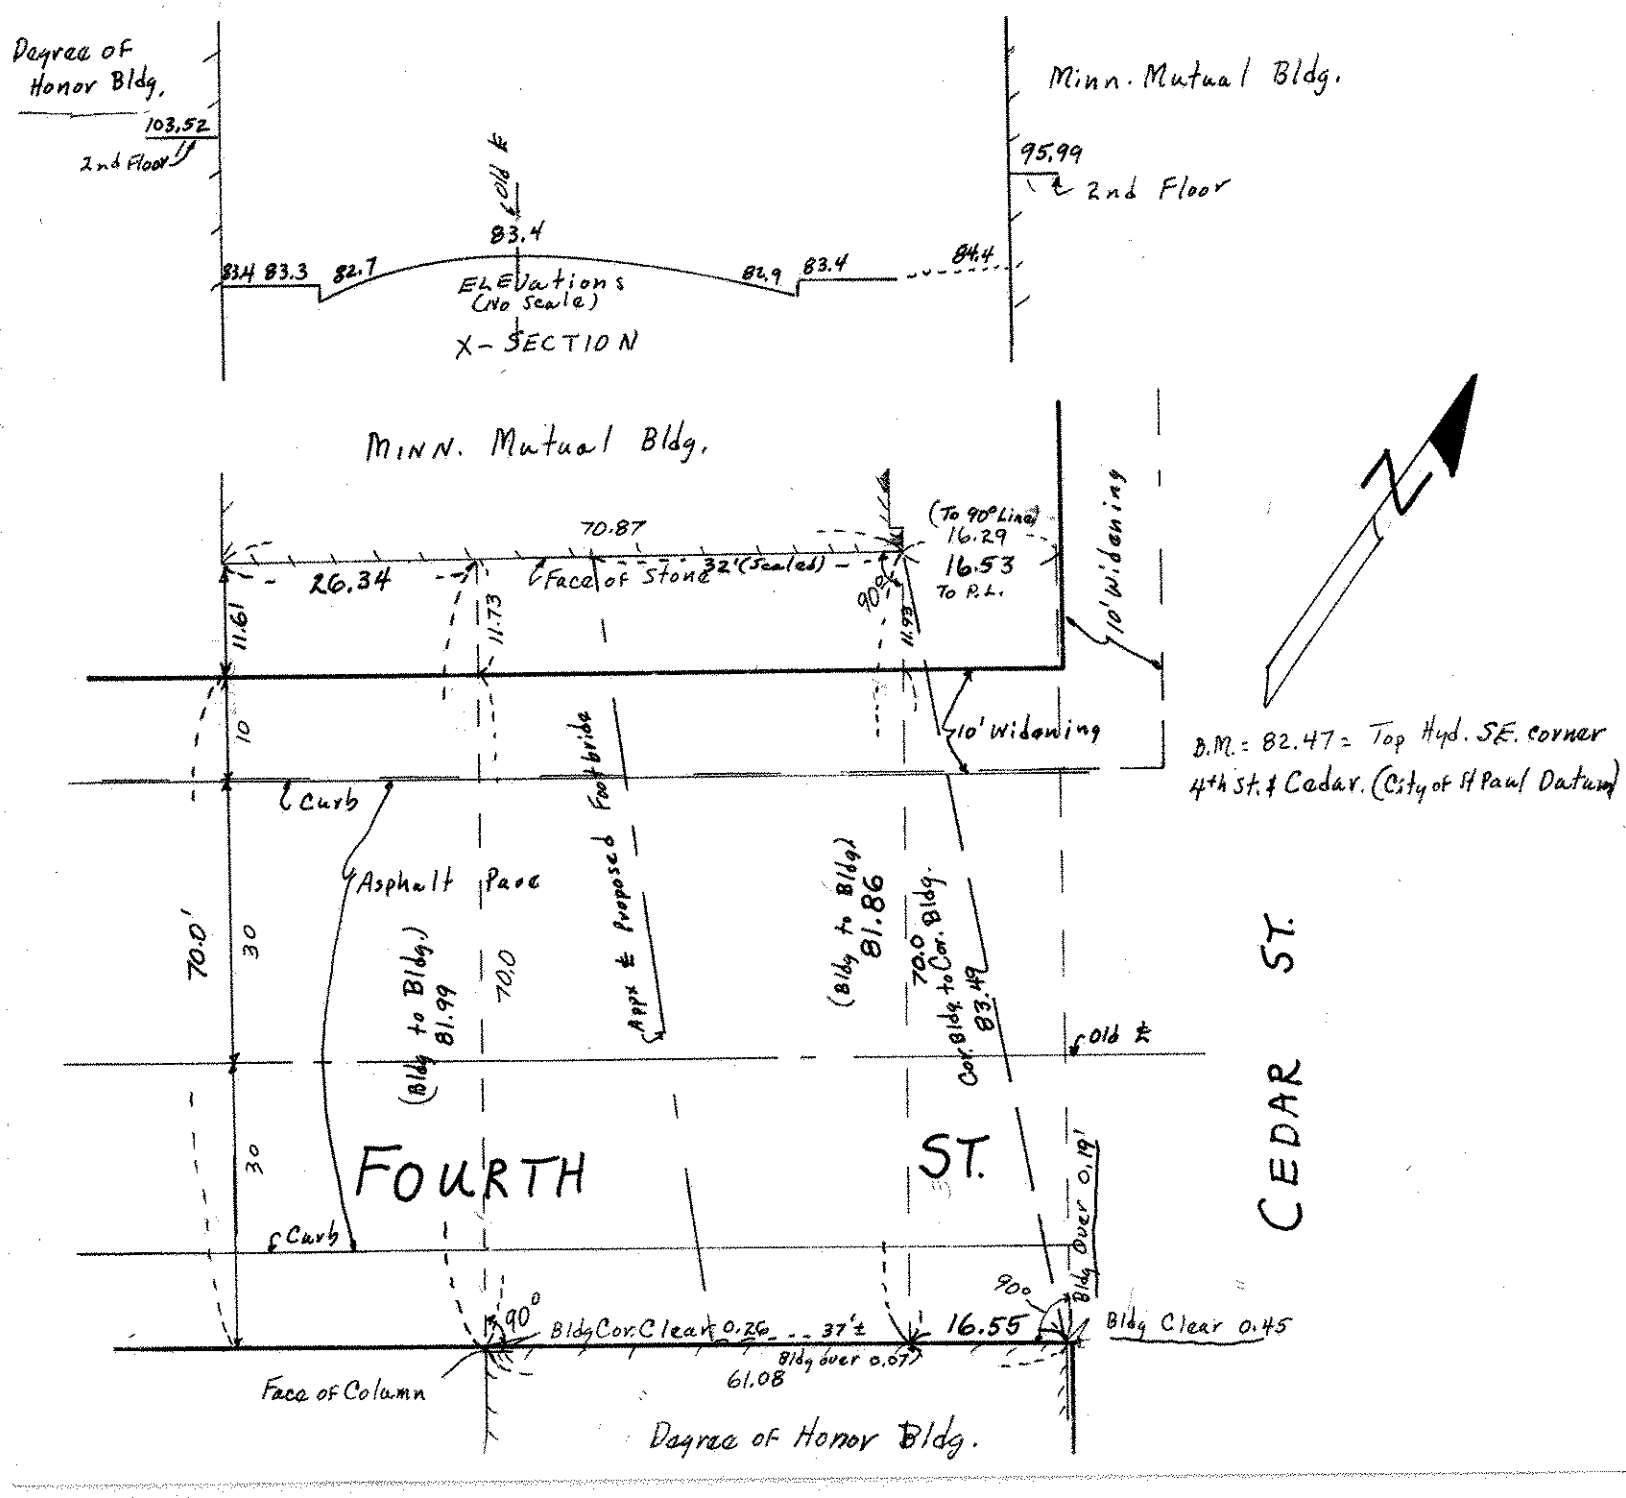

B.M. = 82.47 = Top Hyd. S.E. corner 4th St. & Cedar. (City of St Paul Datum)