NE 6 28 22

FROM THE OFFICE OF

CHARLES O. GEORGI COMPANY

2215 West County Road B — Saint Paul, Minnesota 55113

REGISTERED CIVIL ENGINEER AND LAND SURVEYOR

Certificate of Survey

I Hereby Certify that this plat shows a survey made by me of the property described on this plat, and that the corners are correctly placed as shown, and that all locations have been correctly shown.

4/77 Added Profile & Plan View — 3-2-78 Added data *

Surveyed For Housing Authority

Date August 1976

Scale 1" = 20'

By Charles O. Georgi
REGISTERED LAND SURVEYOR

Footbridge between Bremer Arcade & Donaldson's across 7th Street.
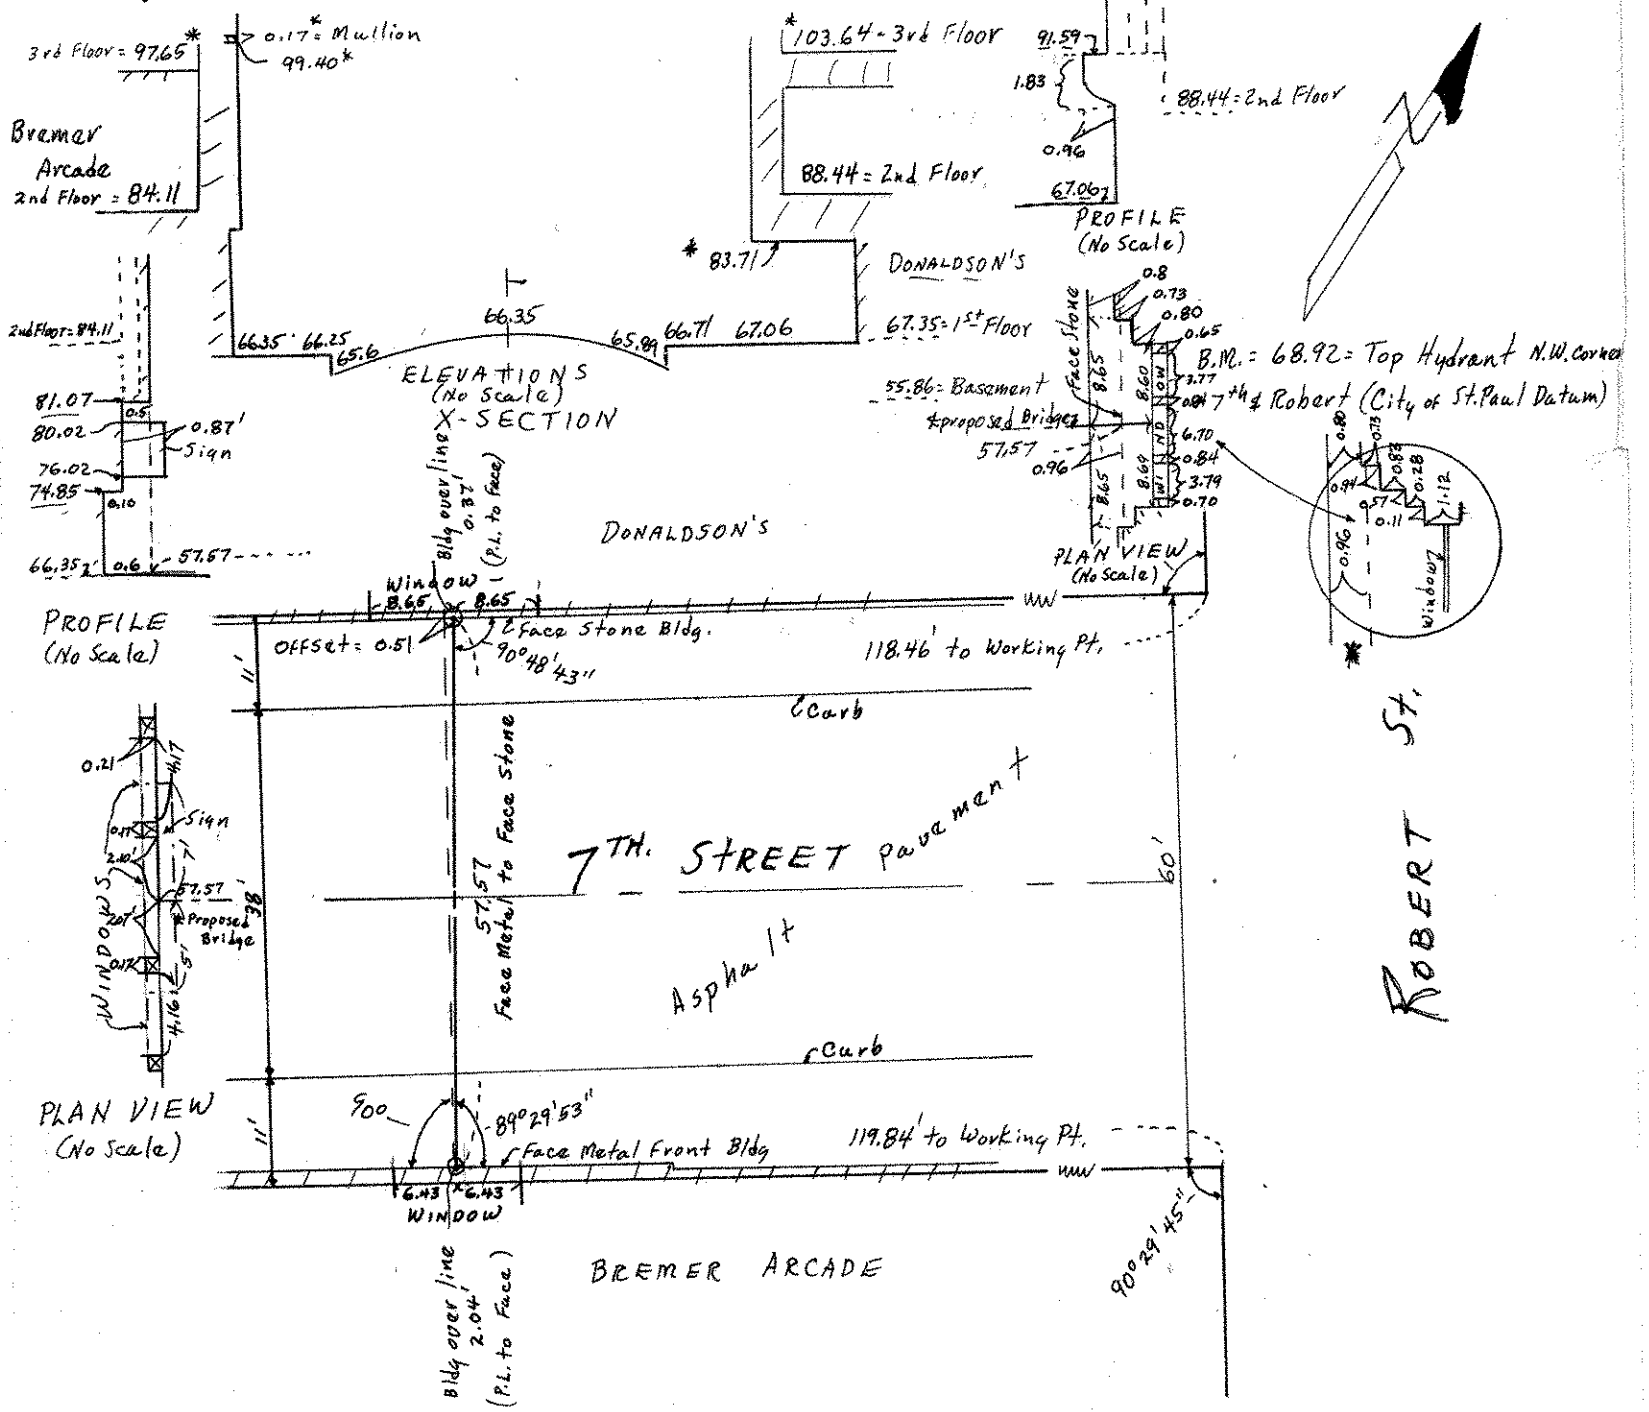
Description: