

NE 6 28 22

FROM THE OFFICE OF

CHARLES O. GEORGI COMPANY

2215 West County Road B

Saint Paul, Minnesota 55113

REGISTERED CIVIL ENGINEER AND LAND SURVEYOR

Certificate of Survey

I Heroby Certify that this plat shows a survey made by me of the property described on this plat, and that the corners are correctly placed as shown, and that all locations have been correctly shown.

477 Added 89°52'09" angle

Surveyed For Housing Authority



Date December 1976

Scale 1" = 20'

By Charles O. Georgi
REGISTERED LAND SURVEYOR

Footbridge between Degree of Honor Bldg.
and St. Paul Abstract Bldg.

Description:

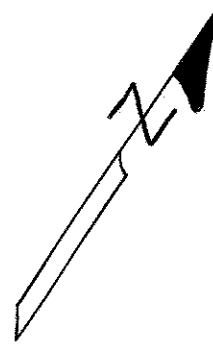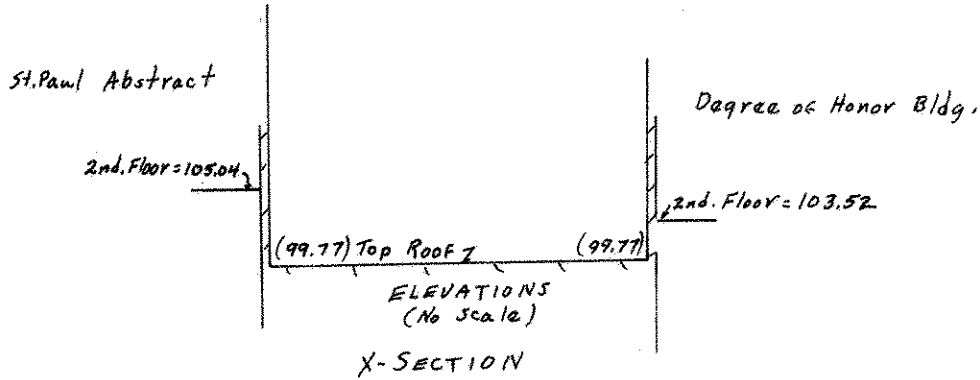

B.M. = 82.47 = Top Hyd S.E. corner
4th St & Cedar (City of St. Paul Datum)

FOURTH STREET

