NE 6 28 22

FROM THE OFFICE OF

CHARLES O. GEORGI COMPANY

2215 West County Road B — Saint Paul, Minnesota 55113

REGISTERED CIVIL ENGINEER AND LAND SURVEYOR

Certificate of Survey

I Hereby Certify that **this plat shows a survey made by me of the property described on this plat, and that the corners are correctly placed as shown, and that all locations have been correctly shown.**

4/77 Added Profile & Plan View

Footbridge between Donaldson's & Metro Square across Robert St.

Surveyed For Housing Authority

Date August 1976

Scale 1" = 20'

By Charles O. Georgi
REGISTERED LAND SURVEYOR
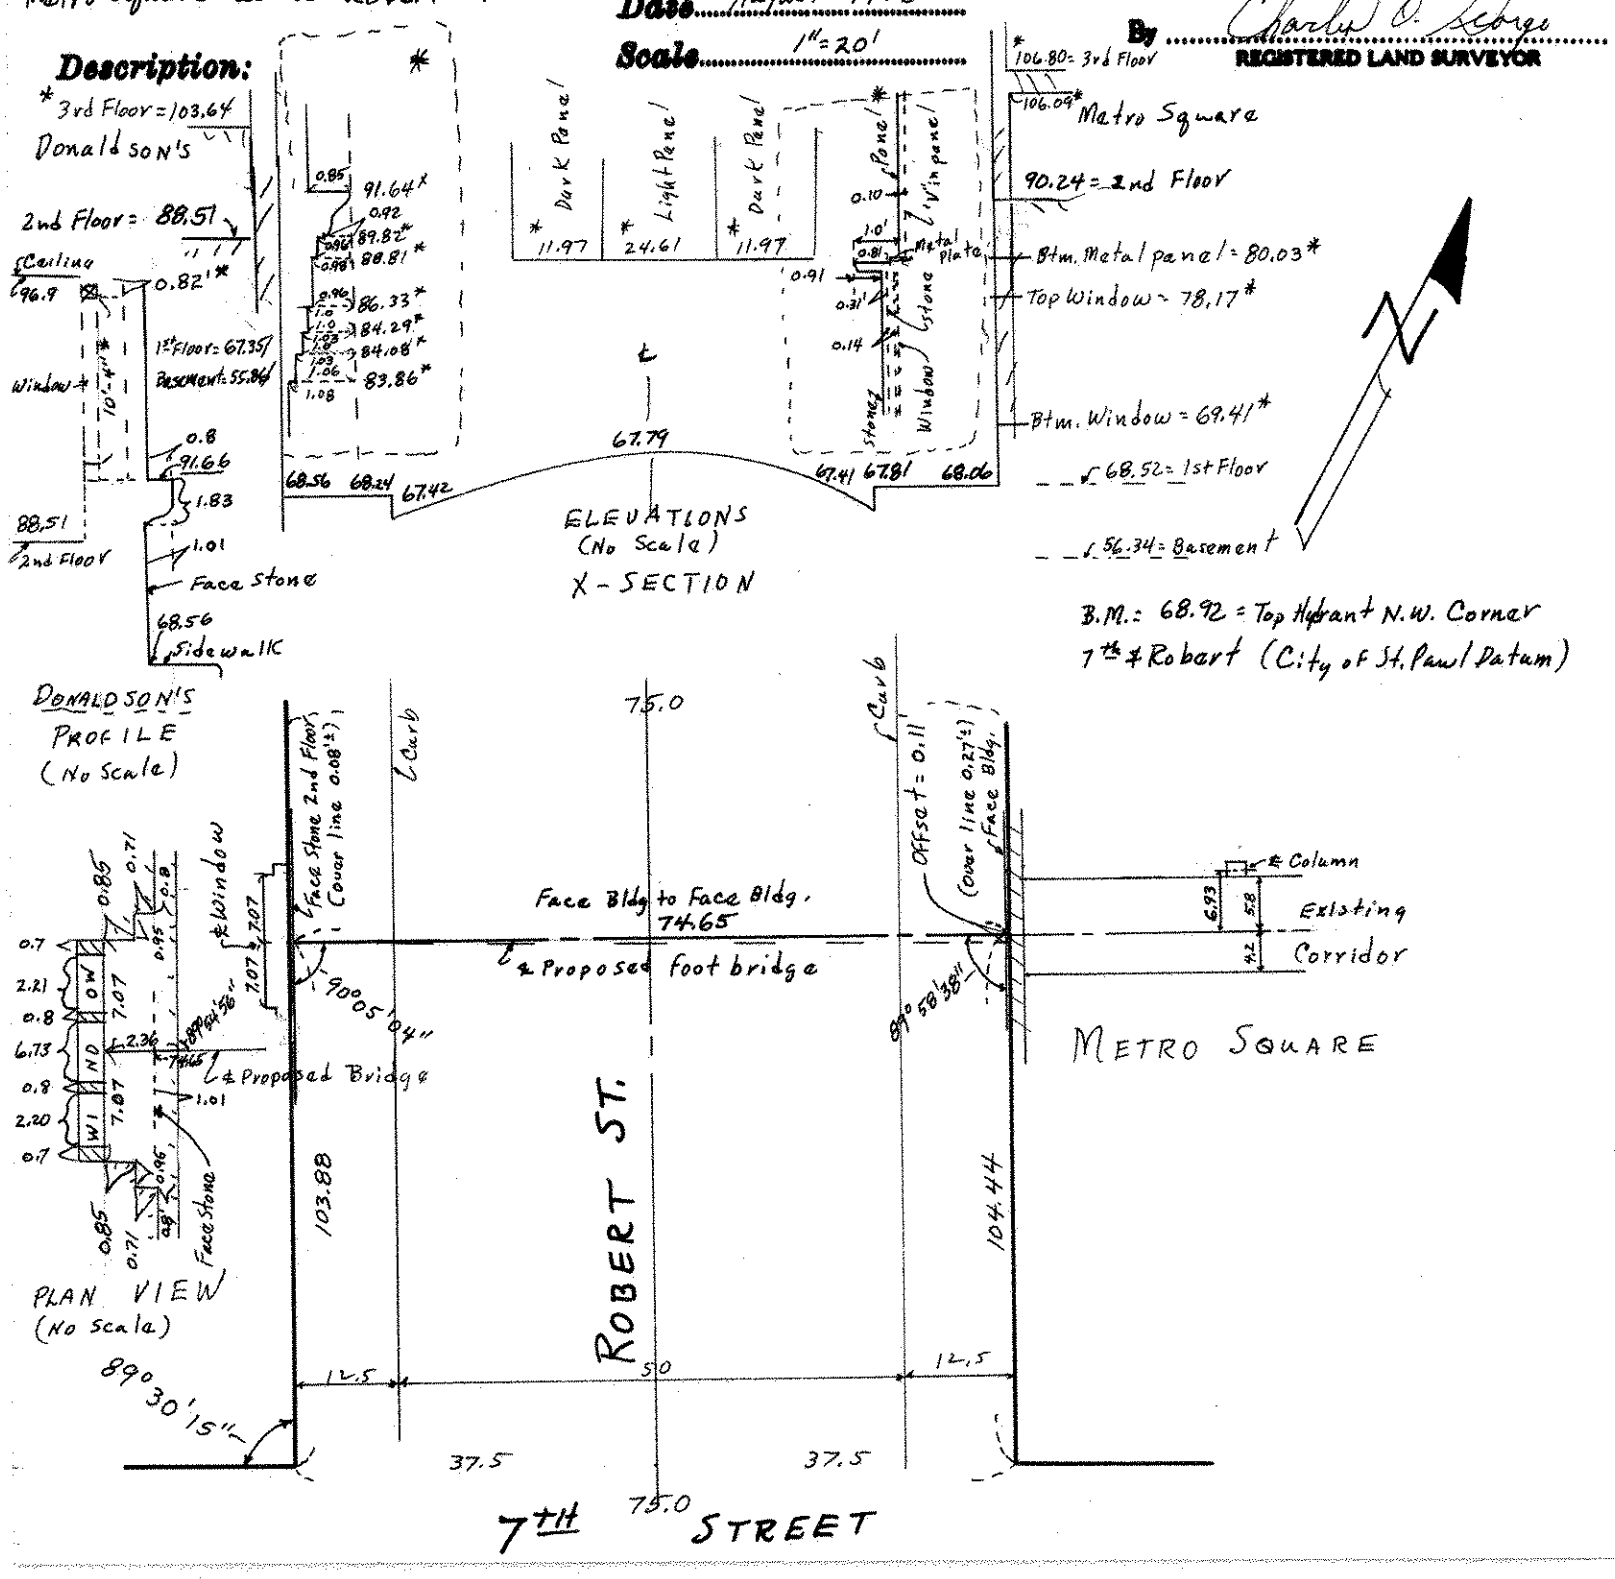
Description: