

NE 6 28 22

FROM THE OFFICE OF

CHARLES O. GEORGI COMPANY

2215 West County Road B

Saint Paul, Minnesota 55113

REGISTERED CIVIL ENGINEER AND LAND SURVEYOR

Certificate of Survey

I Hereby Certify that this plat shows a survey made by me of the property described on this plat, and that the corners are correctly placed as shown, and that all locations have been correctly shown.

Foot bridge within Radisson Hotel

Surveyed For Housing Authority

Date December 1976

Scale 1" = 80' ±

By Charles O. Georgi
REGISTERED LAND SURVEYOR


Description:

SKETCH COPIED FROM PEDESTRIAN CONCOURSE SYSTEM MAP
of Housing & Redevelopment Authority of St Paul.



B.M. = 97.29 = Top Hyd NE 4th & Wabasha
(City of St. Paul Datum)

FOURTH ST.

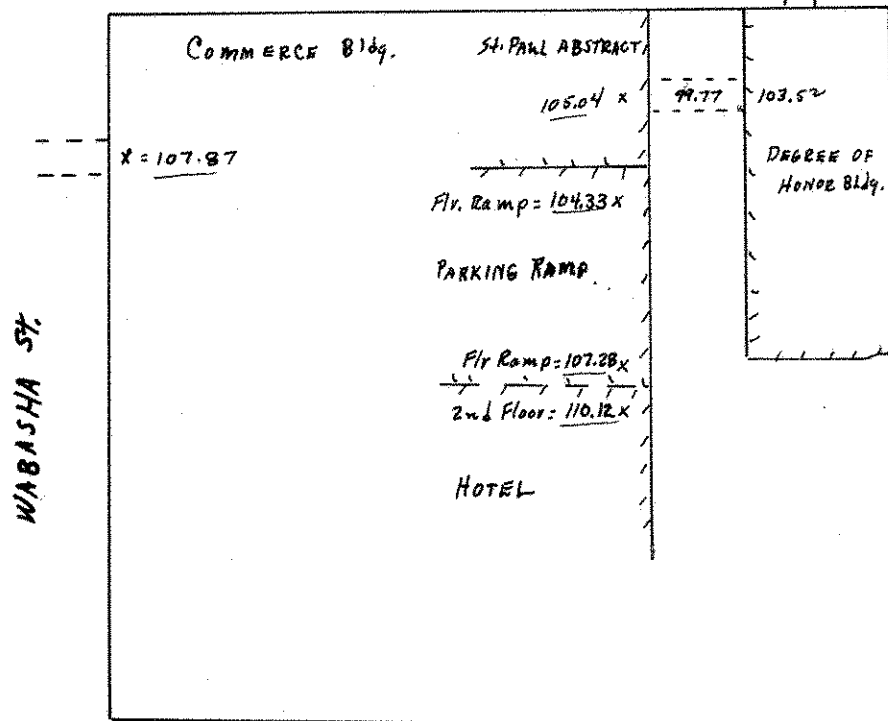

KELLOGG BLVD.