SE 11 28 22

FROM THE OFFICE OF

CHARLES O. GEORGI COMPANY

2215 West County Road B Saint Paul, Minnesota 55113

REGISTERED CIVIL ENGINEER AND LAND SURVEYOR

Certificate of Survey

I Hereby Certify that **this plat shows a survey made by me of the property described on this plat, and that the corners are correctly placed as shown, and that all locations have been correctly shown.**

Surveyed For Dolt Lieberan

Date October 1976

Scale 1" = 60'

By Donald W Schmidt
REGISTERED LAND SURVEYOR

Description:

The Southeasterly 1/2 of lot 3, Lots 4, 5, 6 and 43, Northeasterly 1/2 of lot 42, Block 18, Burlington Heights Division No. 2

Together with a 30 feet driveway easement over and across the NW 1/4 30 feet of the NE 1/4 100 feet of Lot 7, Block 18, Burlington Heights Div. #2.

Ramsey County, Minn.

Surveyor's Note:
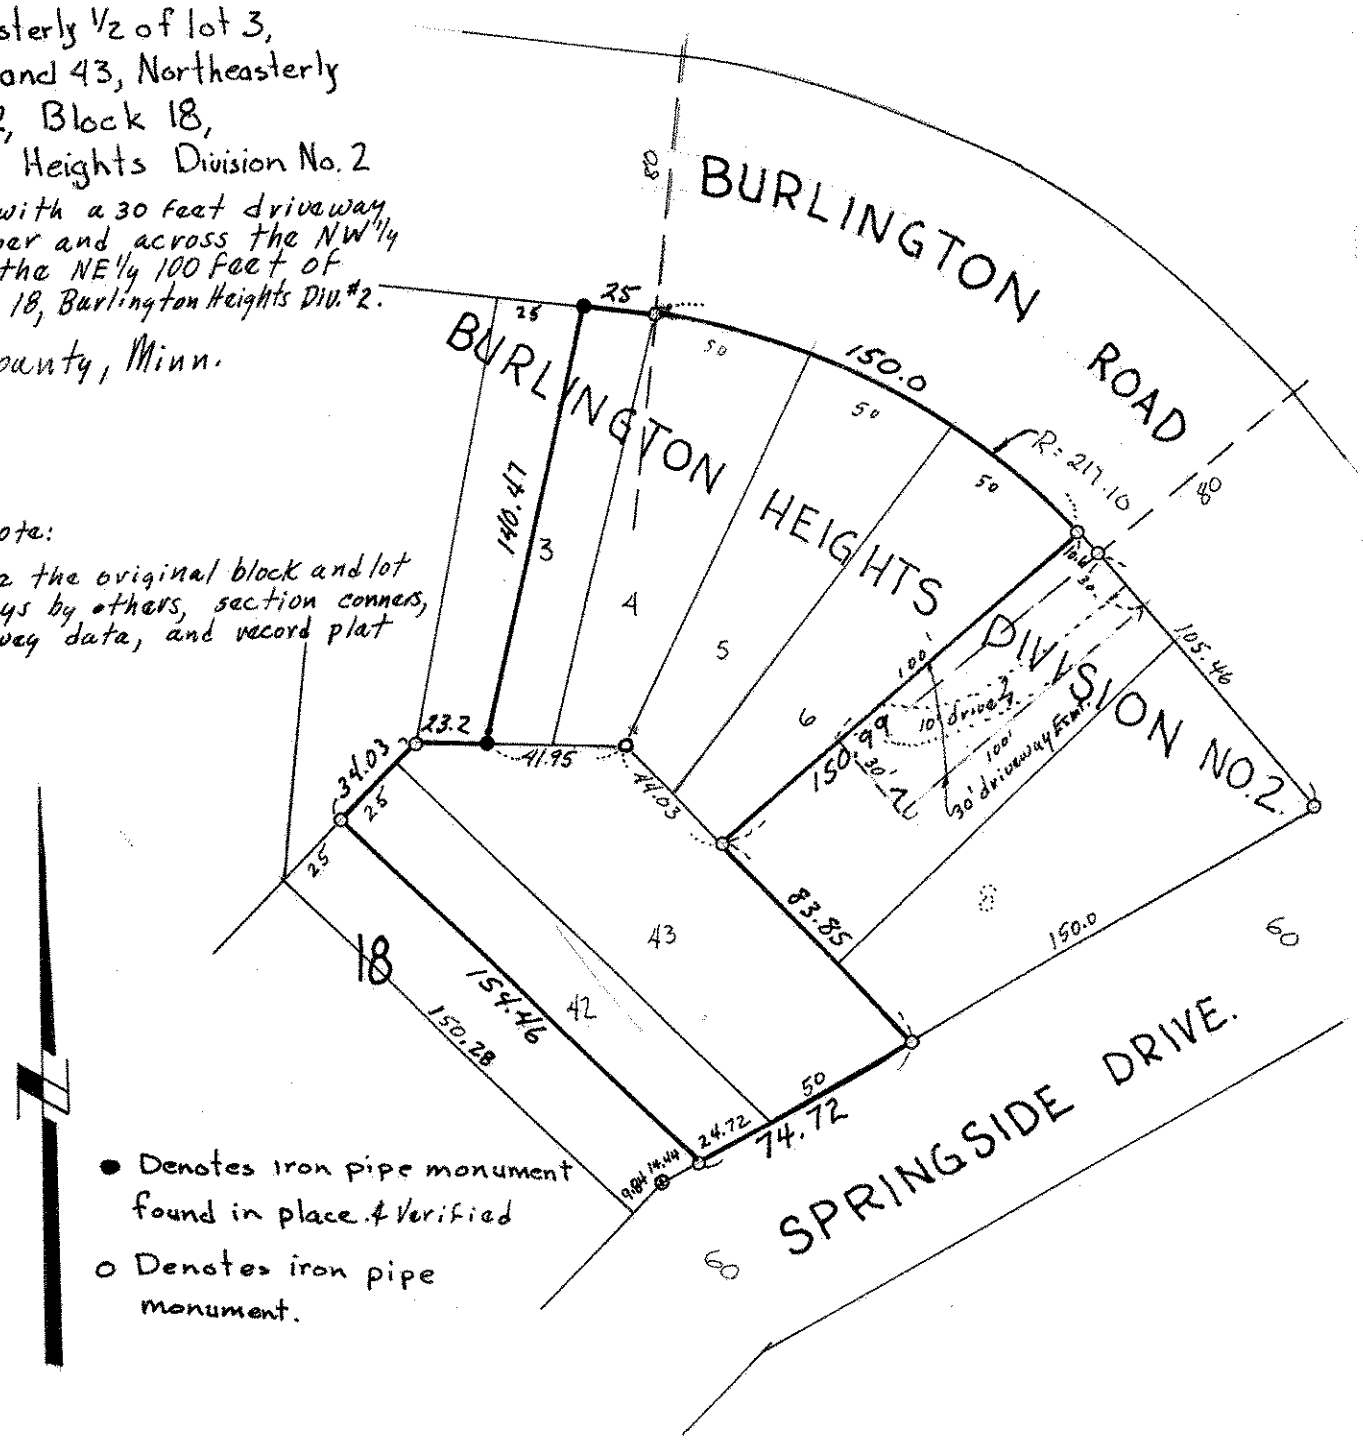
To retrace the original block and lot lines, surveys by others, section corners, standard survey data, and record plat was used.