SE 14 2822

Certificate of Survey

FROM THE OFFICE OF

CHARLES O. GEORGI COMPANY

2215 West County Road B Saint Paul, Minnesota 55113

REGISTERED CIVIL ENGINEER AND LAND SURVEYOR

I Hereby Certify that **this plat shows a survey made by me of the property described on this plat, and that the corners are correctly placed as shown, and that all locations have been correctly shown.**

Surveyed For Joseph Peisert

Date August 1976

Scale

By Charles O. Georgi
REGISTERED LAND SURVEYOR

Description:
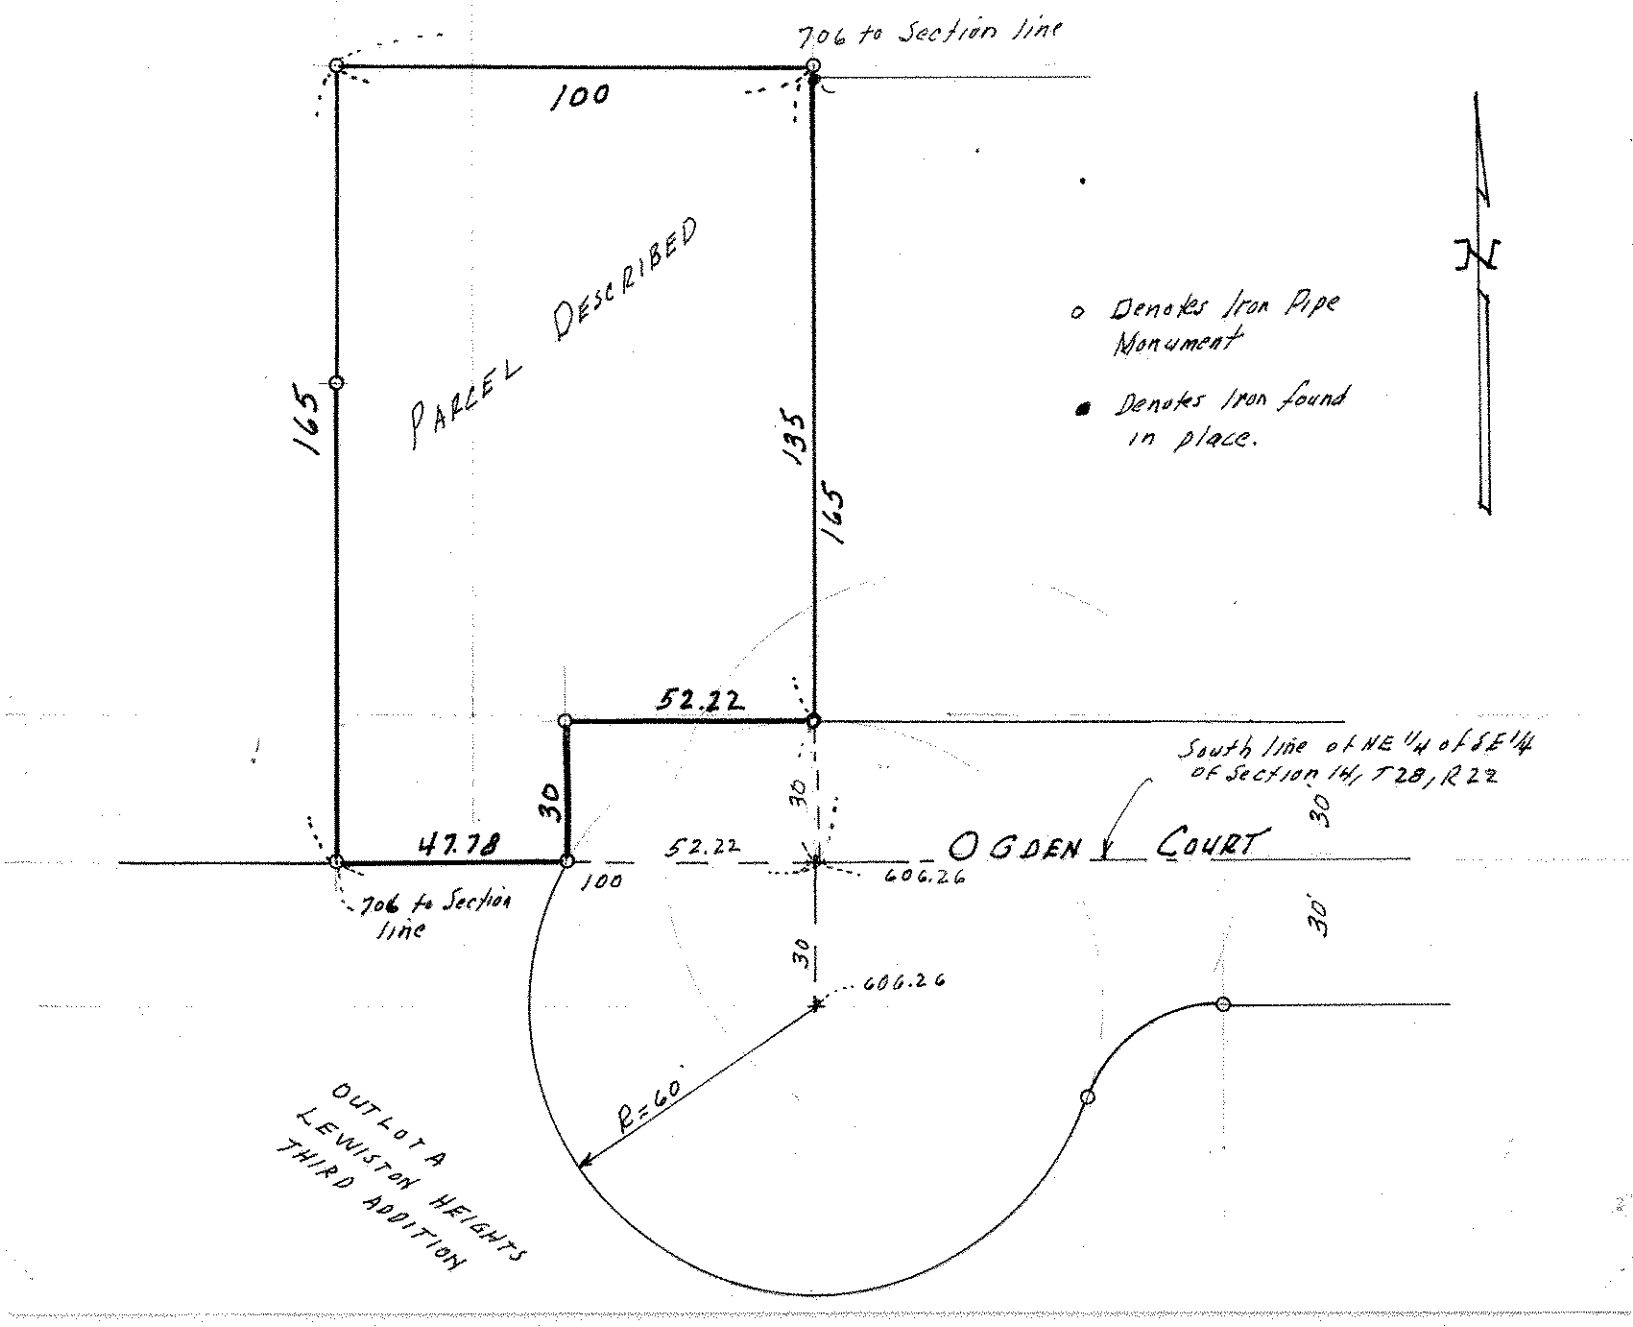
The West 100 feet of the East 706 feet of the South 165 feet of the NE ¼ of the SE ¼ of Section 14, T28, R22, Subject to Ogden Court, Ramsey County, Minnesota.