SW 28 29 23

FROM THE OFFICE OF

CHARLES O. GEORGI COMPANY

2215 West County Road B Saint Paul, Minnesota 55113

REGISTERED CIVIL ENGINEER AND LAND SURVEYOR

Certificate of Survey

I Hereby Certify that this plat shows a survey made by me of the property described on this plat, and that the corners are correctly placed as shown, and that all locations have been correctly shown.

Surveyed For Port Authority

Date January 1977

Scale 1" = 100'

By Donald W Schmidt
REGISTERED LAND SURVEYOR

Description:

The South 635.93 feet of the SW 1/4 of the SW 1/4 of Section 28, T 29 N, R 23 W, lying Westerly of Transfer Road except the South 211.35 feet thereof and except the West 20 feet thereof, Ramsey County, Minnesota.

Contains 3.499 Acres m.o.l.
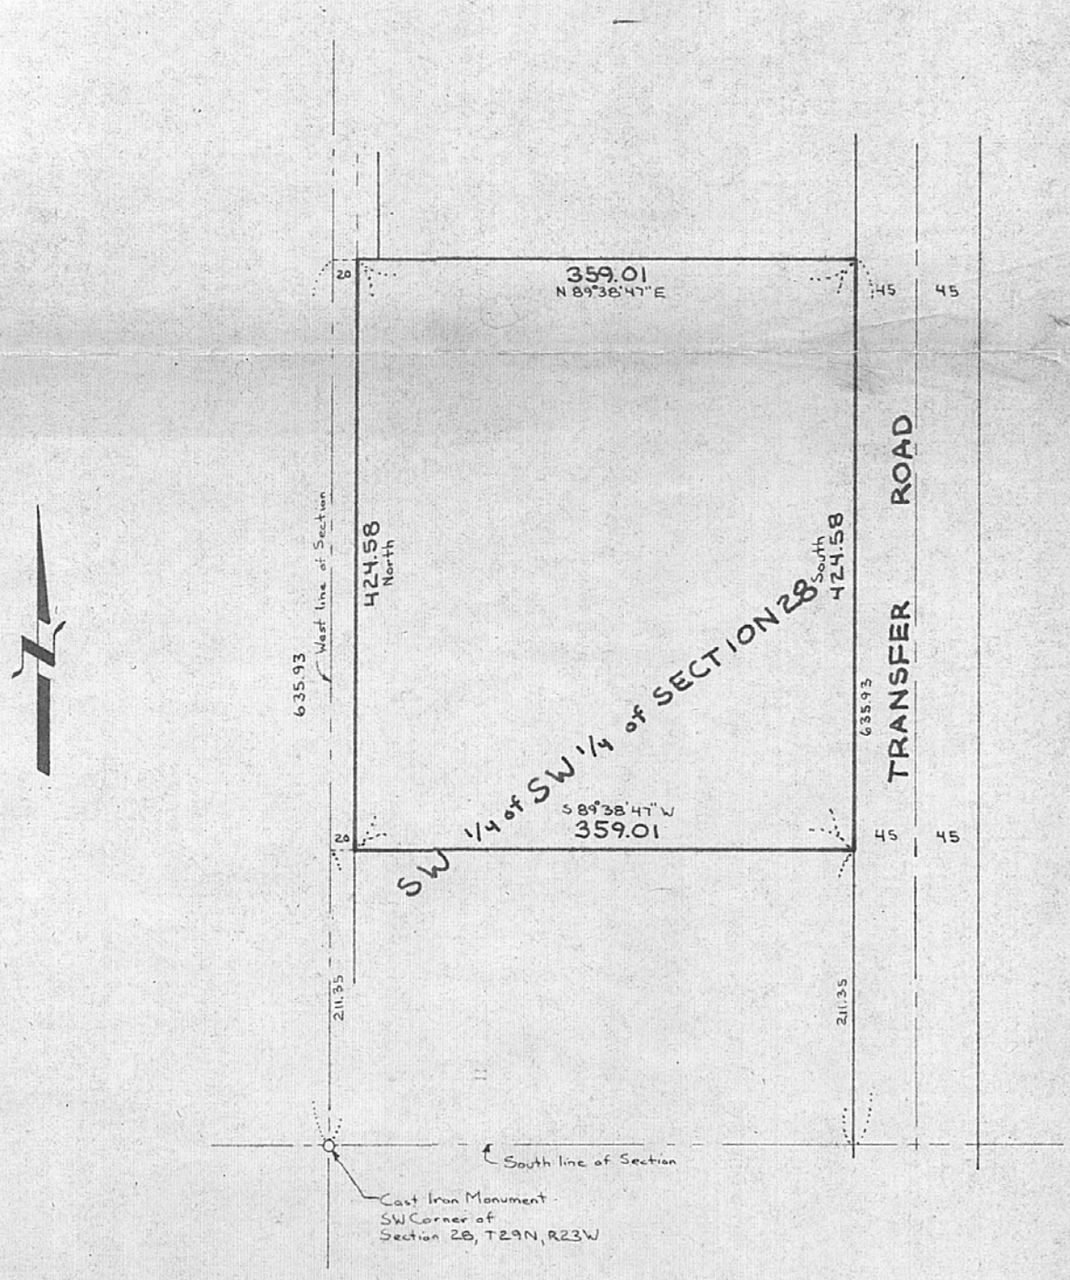
JAN 4 1977