NW 34 30 23

FROM THE OFFICE OF

CHARLES O. GEORGI COMPANY

2215 West County Road B — Saint Paul, Minnesota 55113

REGISTERED CIVIL ENGINEER AND LAND SURVEYOR

Certificate of Survey

I Hereby Certify that **this plat shows a survey made by me of the property described on this plat, and that the corners are correctly placed as shown, and that all locations have been correctly shown.**

1/19/78 Added Bldg, Sidewalk, Parking, & Curb locations C.O.G. 2/20/80 Add Clearances on West side. & Garage DWS

Surveyed For Arden Industrial Products

Date November 1977

Scale 1" = 100'

By Charles O. Georgi
REGISTERED LAND SURVEYOR

Description:
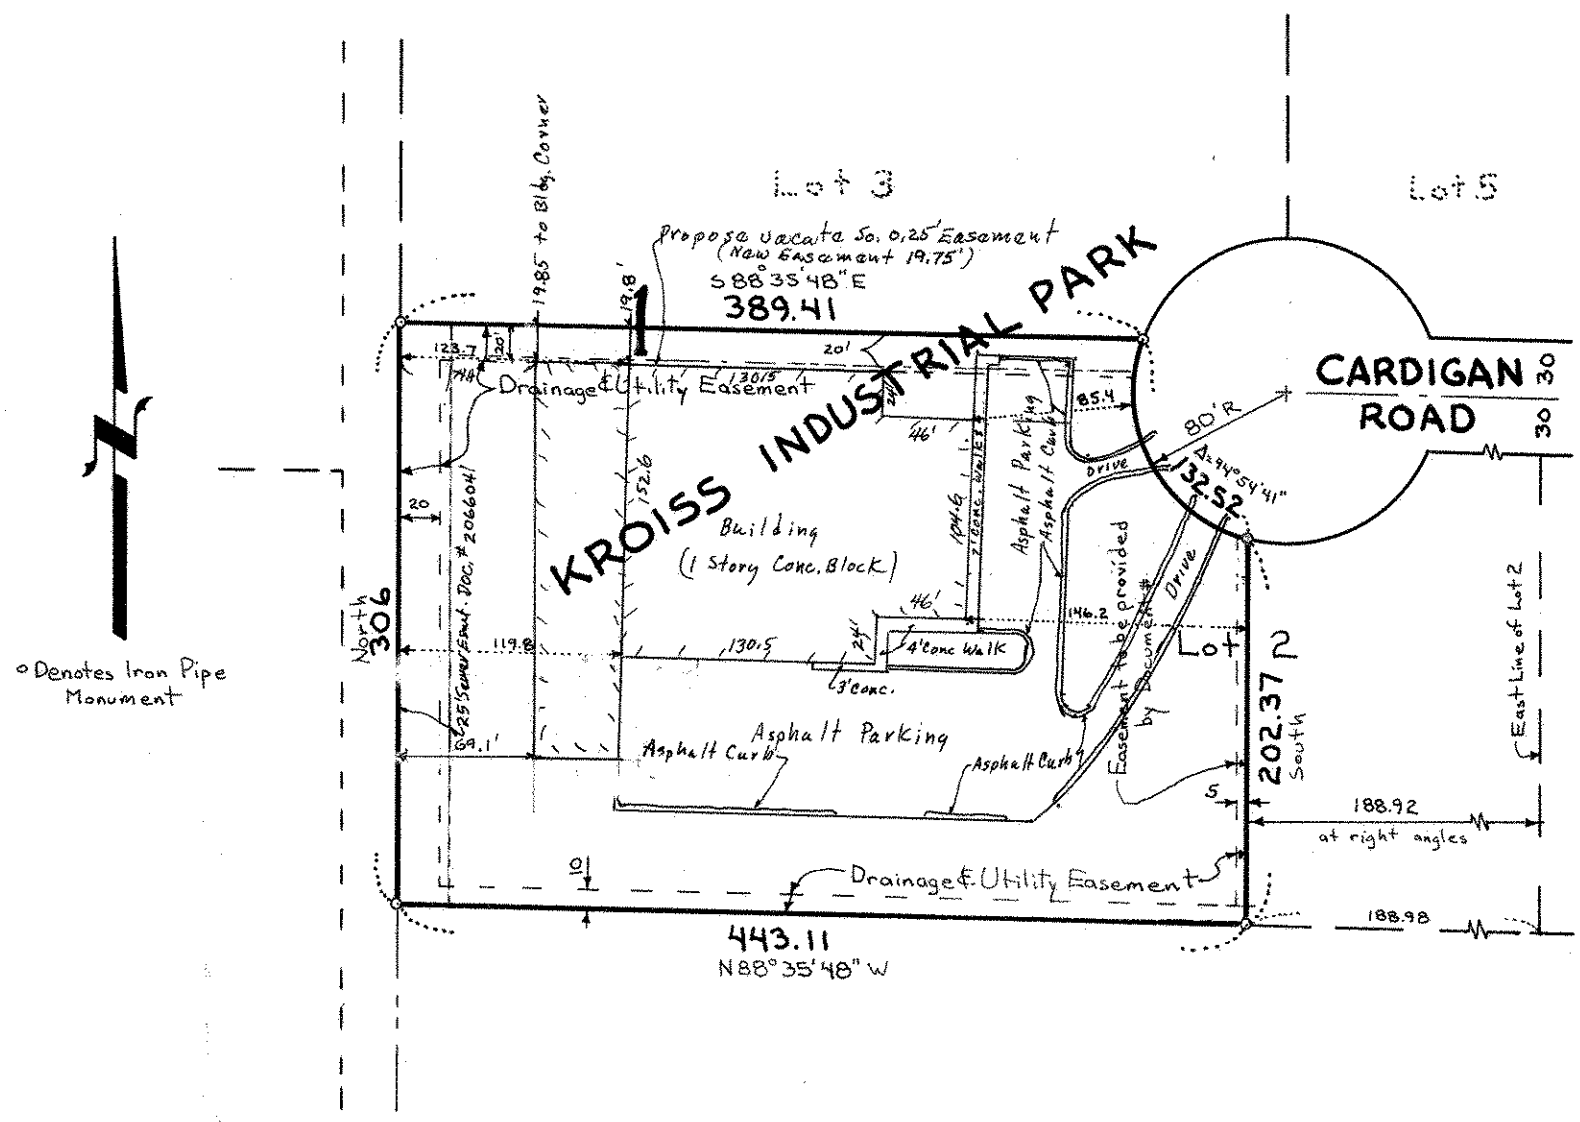
Lot 2 except the East 188.92 feet thereof,
Block 1,
Kroiss Industrial Park,
Ramsey County, Minnesota
Subject to a drainage & utility easement over the East 5 feet thereof.
Contains 3.00 Acres more or less