## FROM THE OFFICE OF

## Certificate of Survey

## **CHARLES O. GEORGI COMPANY**

2215 West County Road B

Saint Paul, Minnoanta 55113

RECEITERED CIVIL ENGINEER AND LAND SURVEYOR

I Hereby Certify that this plat shows a survey made by me of the property described on this plat, and that the corners are correctly placed as shown, and that all locations have been correctly shown.


Surveyed For Gardon White Date May 1977

Scale | " = 50

South O Scopy

## Description:

Lot 19, Block 2, North Owasso Shores Addition No. 2, Ramsey County, Minnesota

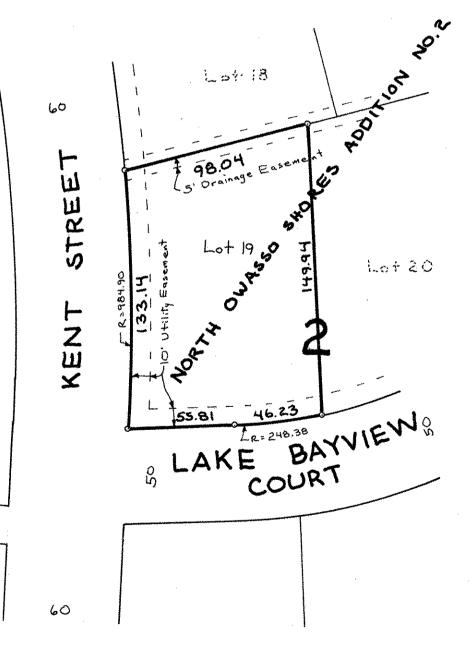

o Denotes Iron Pipe Monument set February 1977

Easements as per plat only