

FROM THE OFFICE OF

CHARLES O. GEORGI COMPANY

2215 West County Road B

Saint Paul, Minnesota 55113

REGISTERED CIVIL ENGINEER AND LAND SURVEYOR



I Heroby Certify that this plat shows a survey made by me of the property described on this plat, and that the corners are correctly placed as shown, and that all locations have been correctly shown. Added house location 8/5/77 C.O.G.

Surveyed For Steve Kroiss


Date June 1977

Scale 1" = 40'

By Charles O. Georgi
REGISTERED LAND SURVEYOR

Description:

Lot 23, Block 2,
North Owasso Shores Addition No. 2,
Ramsey County, Minnesota

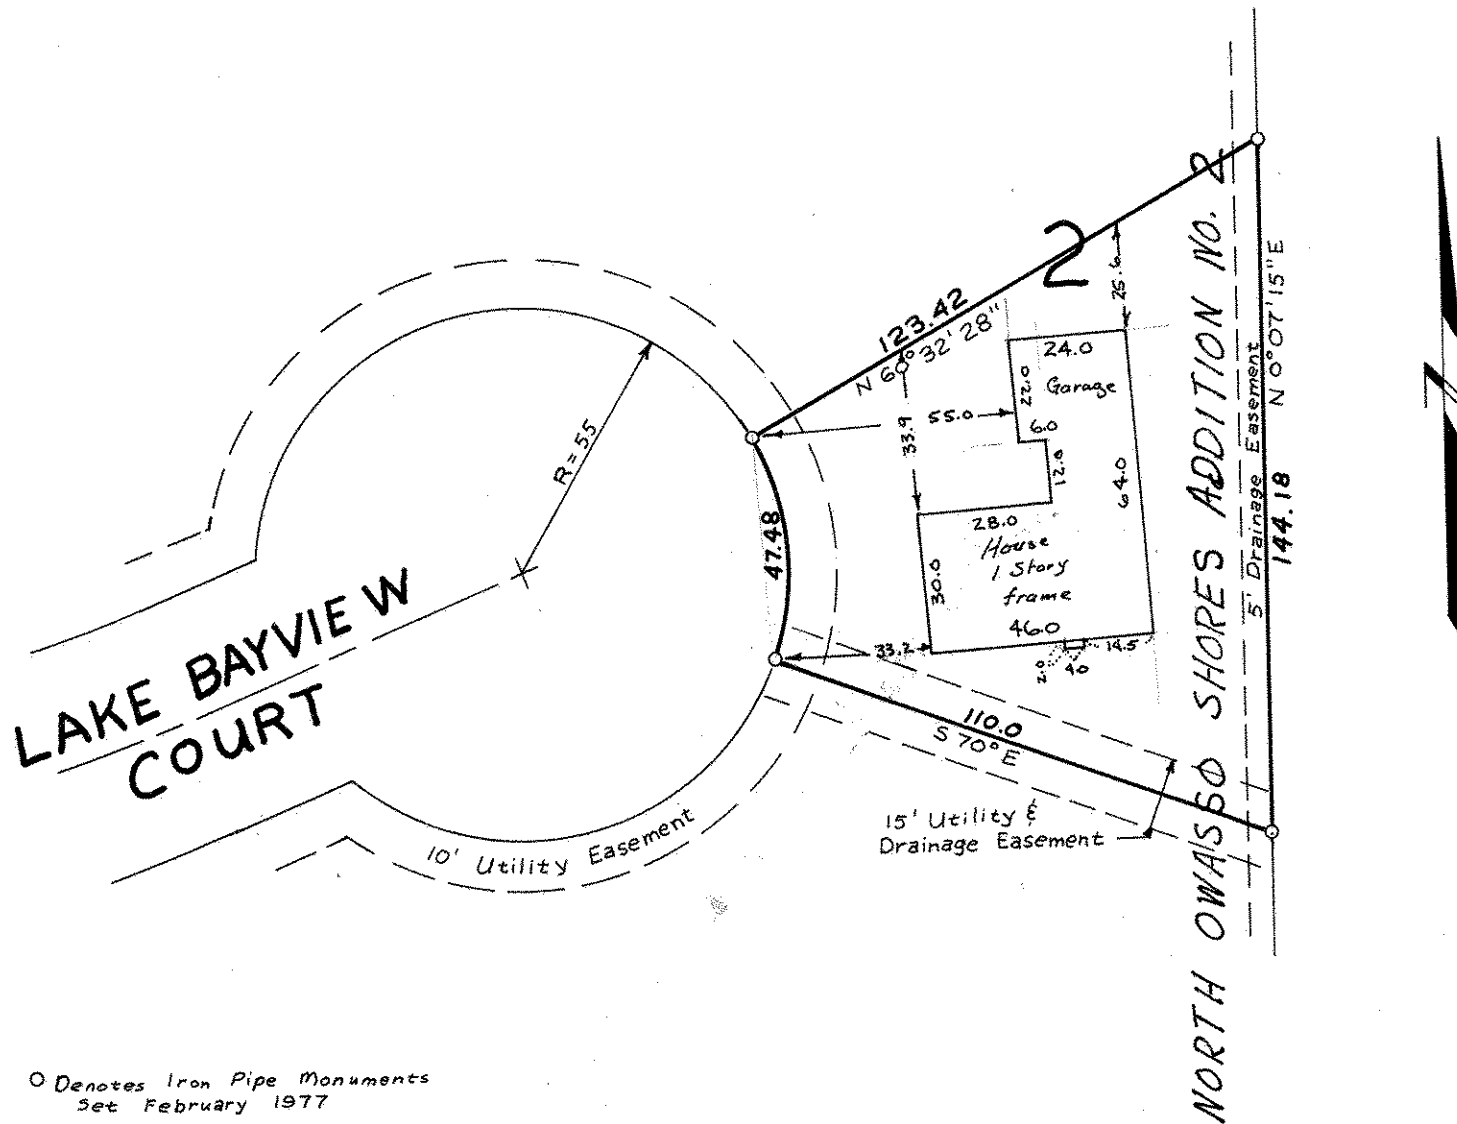

○ Denotes Iron Pipe Monuments
Set February 1977

Easements as per plat only