SW 24 30 22

FROM THE OFFICE OF

CHARLES O. GEORGI COMPANY

2215 West County Road B Saint Paul, Minnesota 55113

REGISTERED CIVIL ENGINEER AND LAND SURVEYOR

Certificate of Survey

I Hereby Certify that **this plat shows a survey made by me of the property described on this plat, and that the corners are correctly placed as shown, and that all locations have been correctly shown.**

Surveyed For Eugene Harren

Date Aug 1977

Scale 1" = 40'

By Charles O. Georgi

REGISTERED LAND SURVEYOR
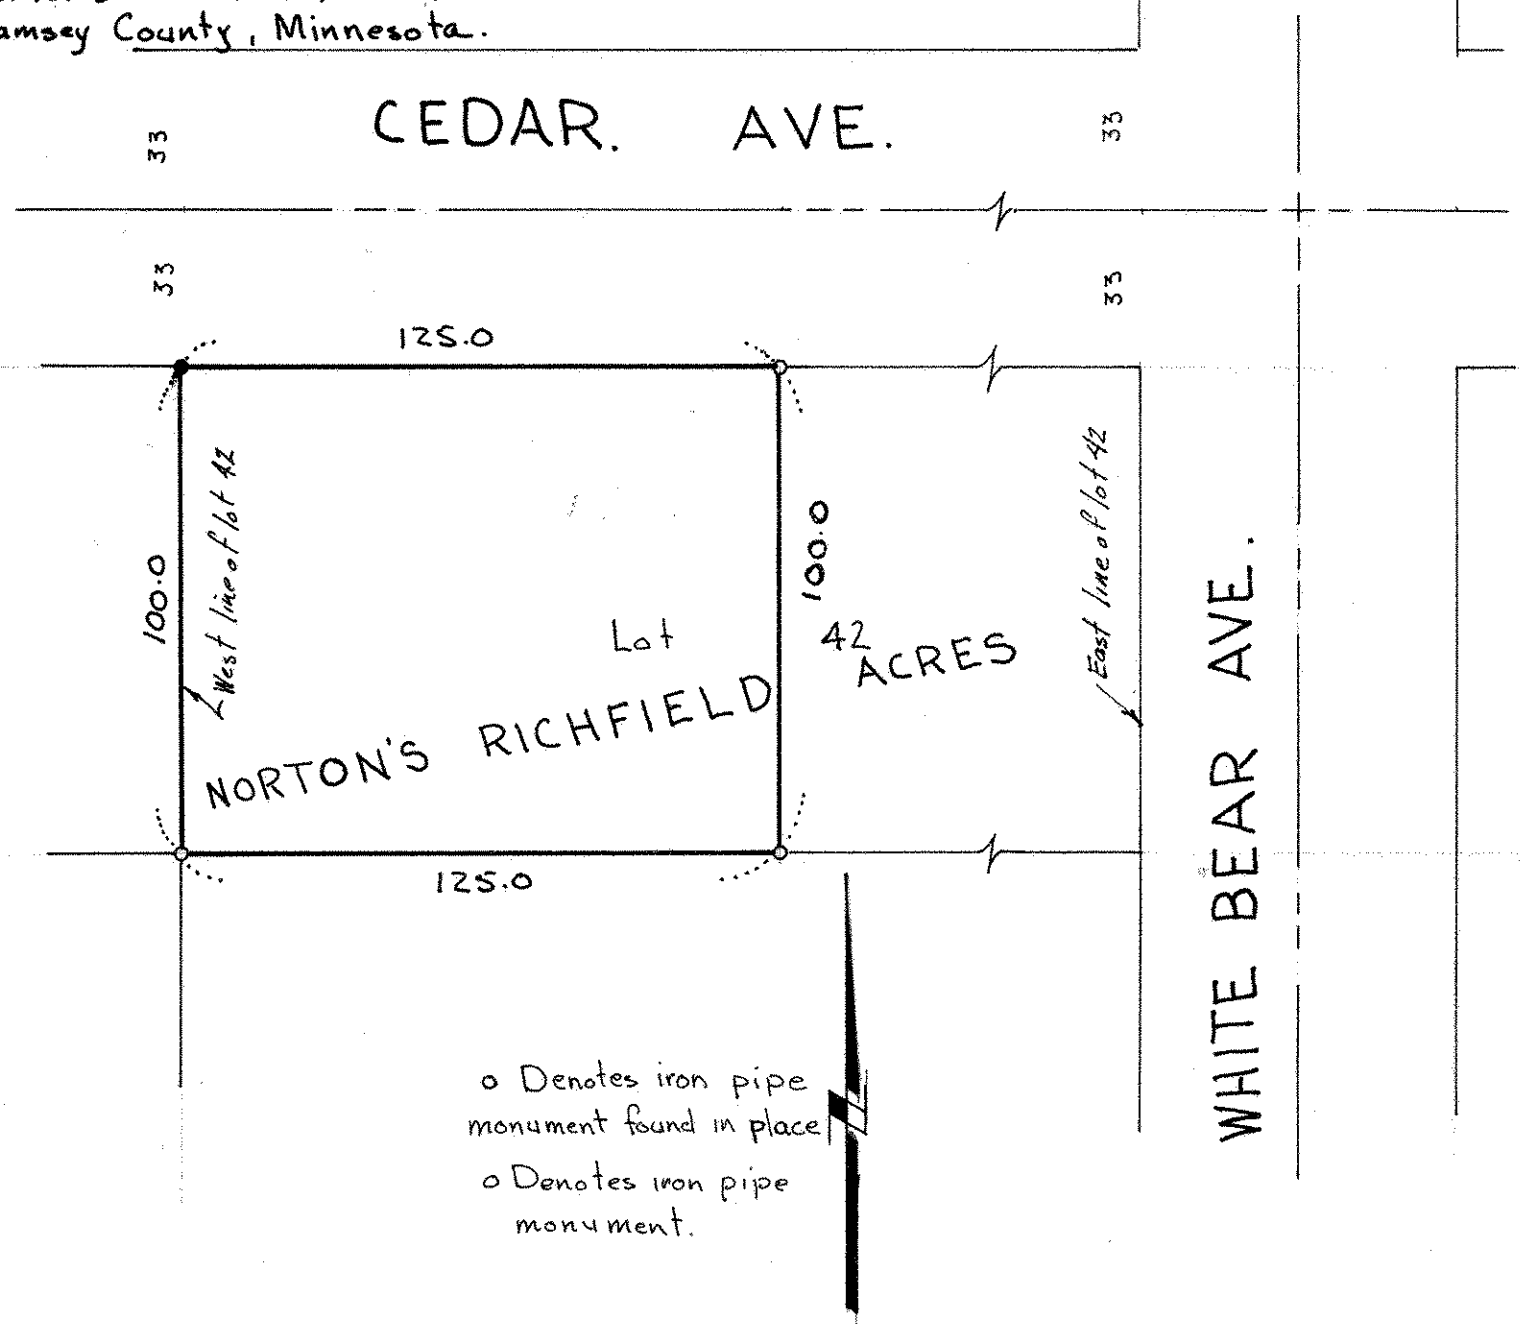
Description:
The West 125.0 feet of lot 42,
Norton's Richfield Acres,
Ramsey County, Minnesota.