NW 1 29 23

Certificate of Survey

FROM THE OFFICE OF

CHARLES O. GEORGI COMPANY

2215 West County Road B Saint Paul, Minnesota 55113

REGISTERED CIVIL ENGINEER AND LAND SURVEYOR

I Hereby Certify that **this plat shows a survey made by me of the property described on this plat, and that the corners are correctly placed as shown, and that all locations have been correctly shown.**

Surveyed For R.C. Witt Construction

Date September 1977

Scale 1" = 30

By Charles O. Georgi
REGISTERED LAND SURVEYOR

Description:

Lot 11,
Block 2,
Swanson Shores,
Ramsey County, Minnesota

• Denotes Iron Pipe Monument
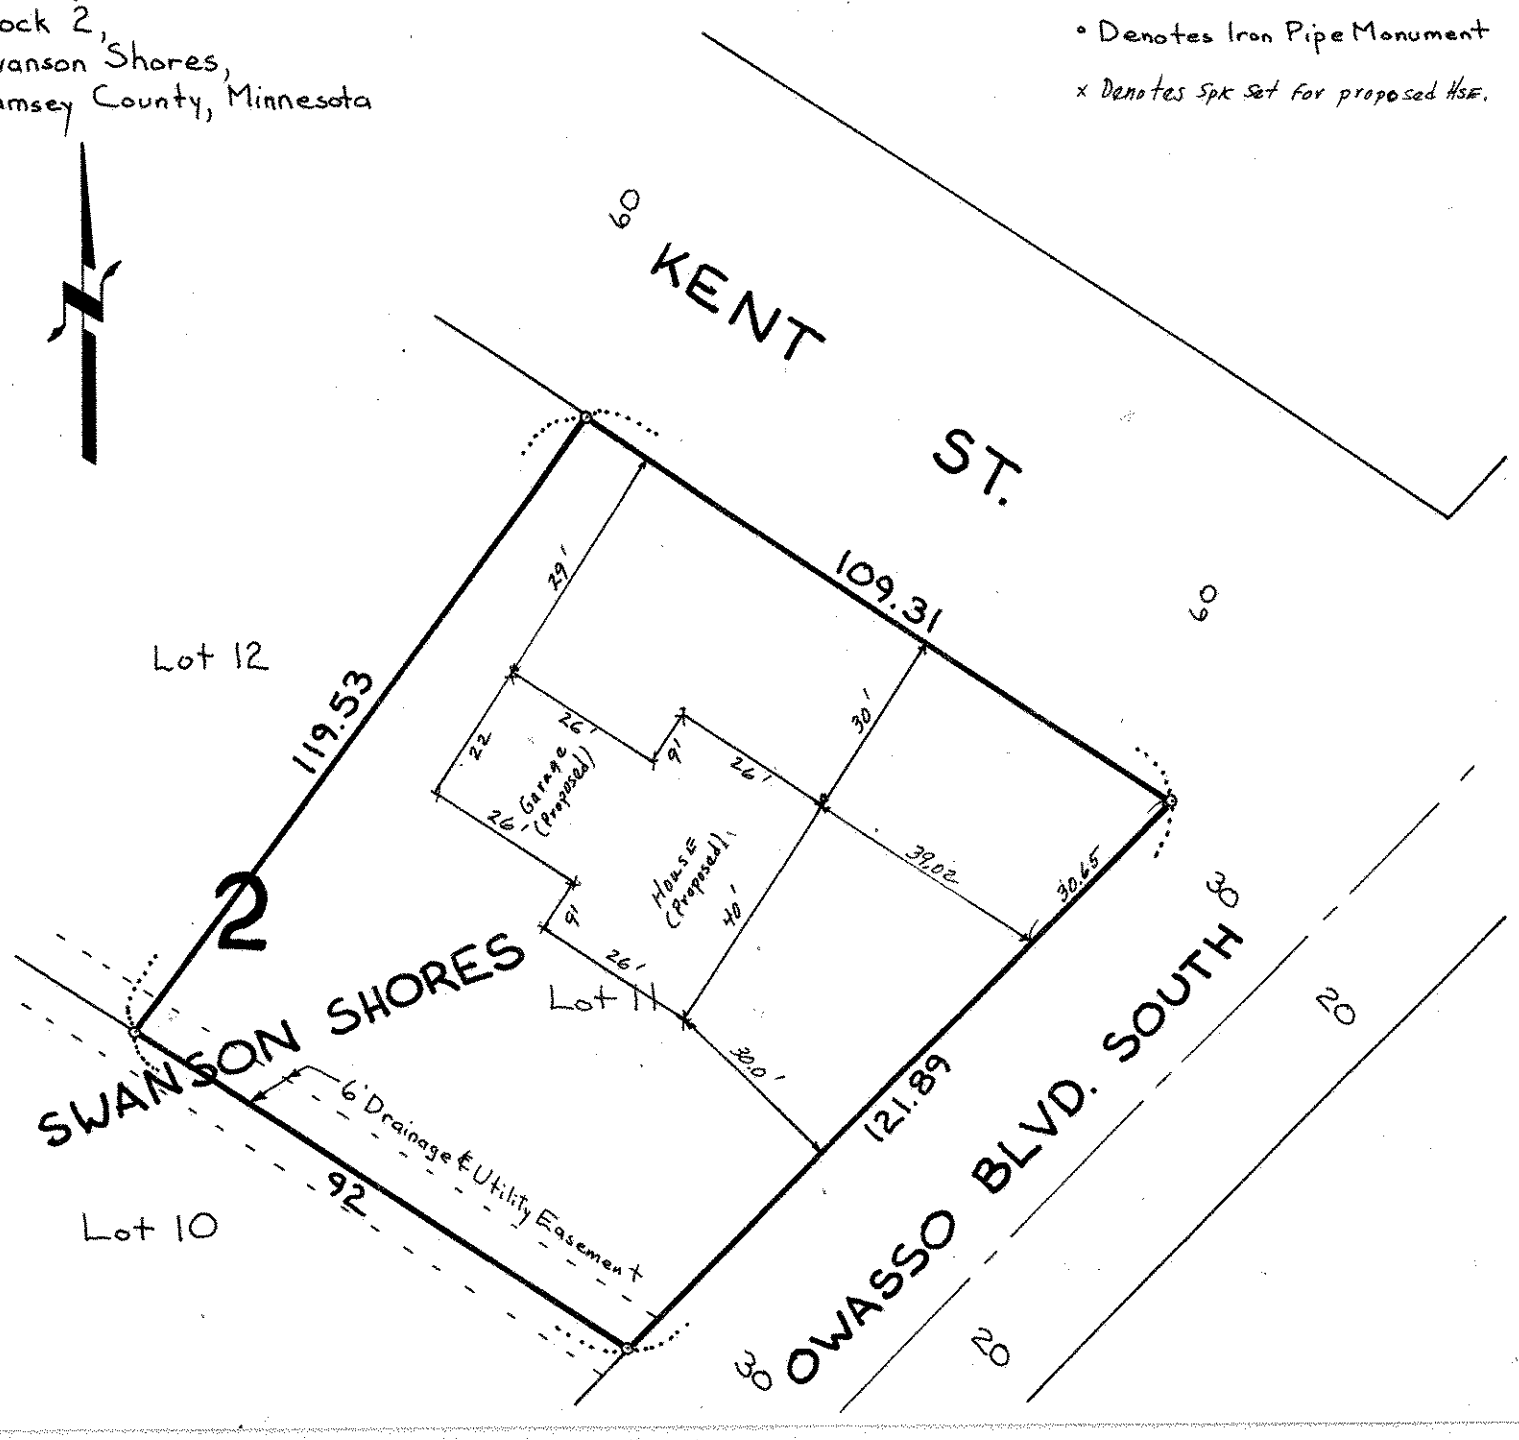
x Denotes Spk Set for proposed HSE.