

18th 4th AVE. S.E.  
ST. CLOUD, MN 56301  
612-251-7751




314 OAK ST.  
SAUK CENTRE, MN 56378  
612-352-3664

500 W HWY. 96, ST. PAUL, MN 55112 612 484-3301

I hereby certify that this Certificate of Survey  Description  Easement  Plan  Specification  or Building Location  was prepared by me or under my direct supervision and that I am a duly Registered Land Surveyor  under the laws of the State of Minnesota.

Reg. No. 2505 Date 3-30-77

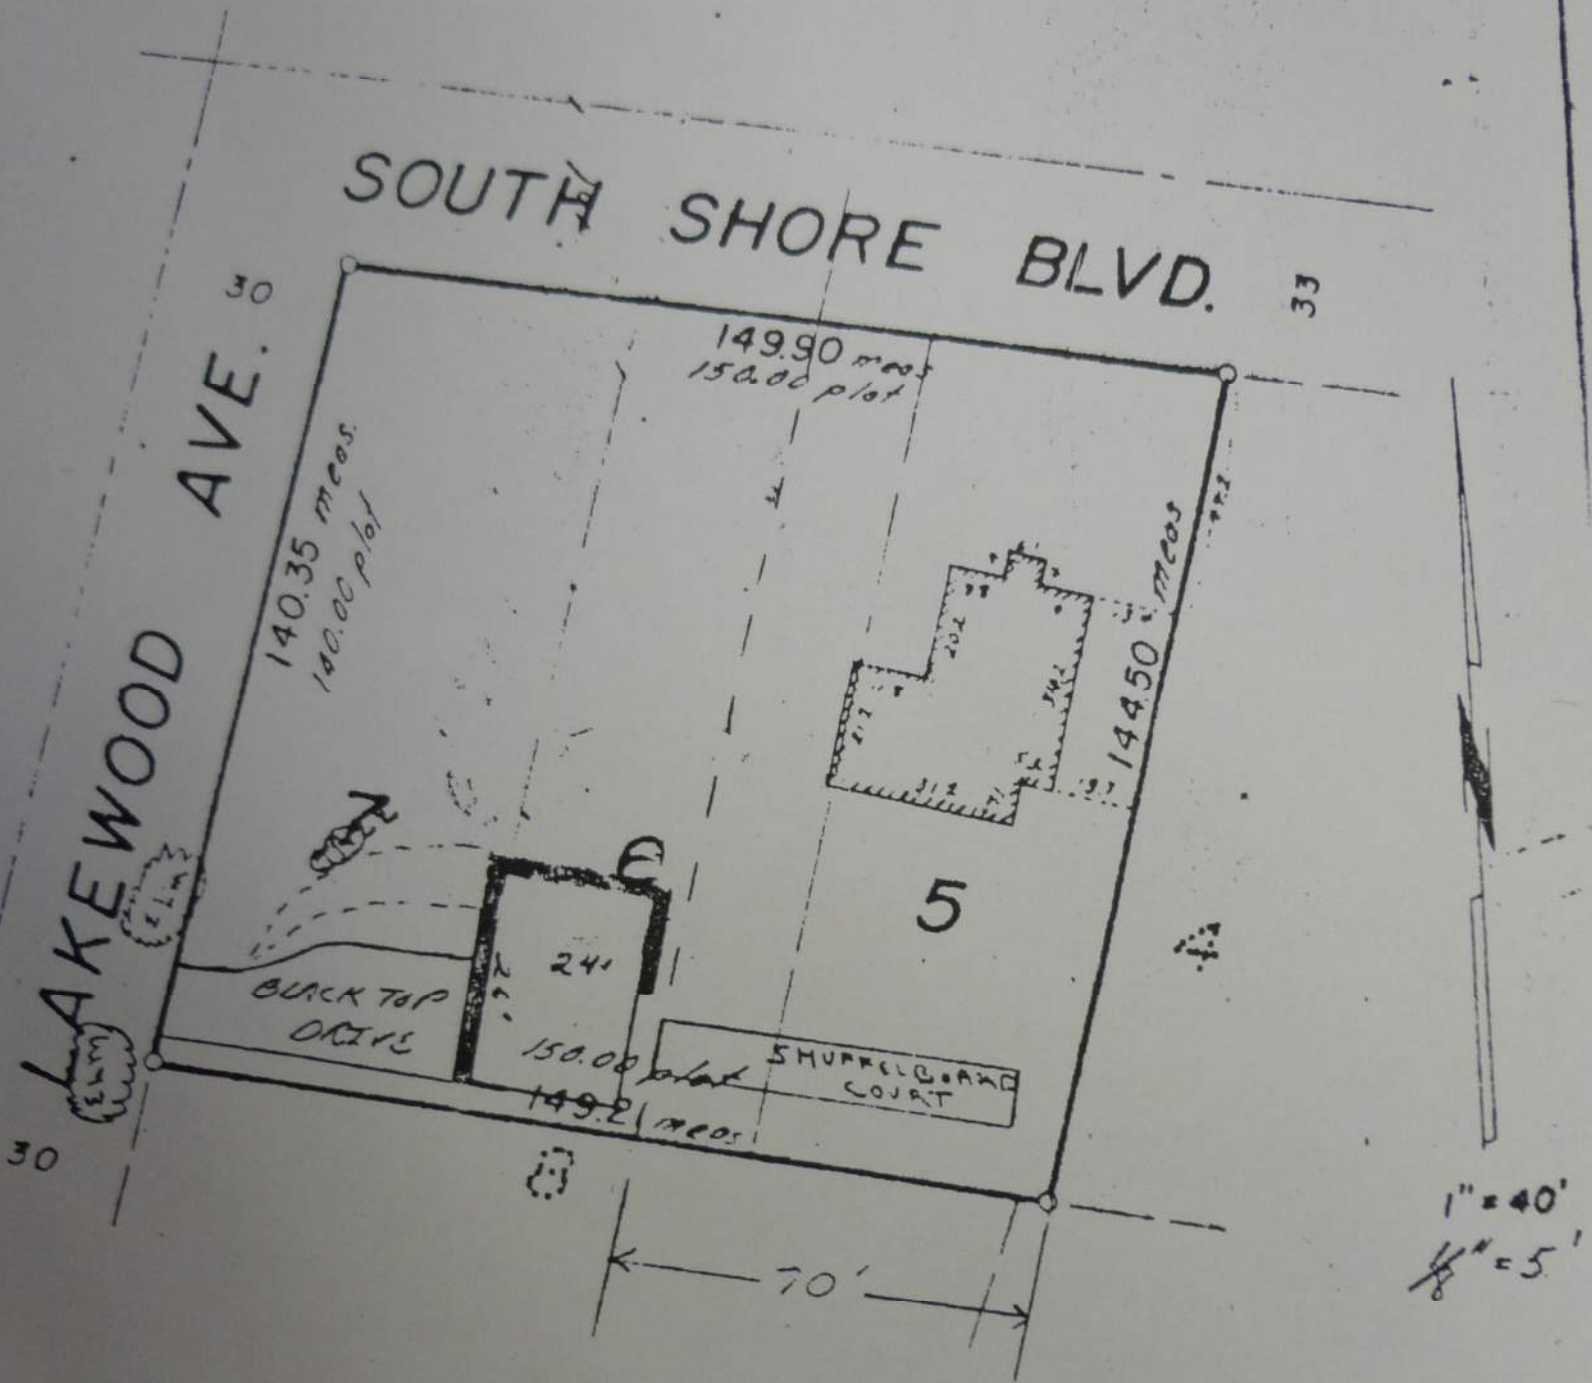

Lots 5, 6 & 7, Block 2, Belleaire, Second, Ramsey County, Minnesota