



Main Office 371,6006
 6275 Highway No. 65 N.E.
 Minneapolis, Minnesota 55432

South Office 890-6510
 1101 Cliff Road
 Birmingham, Minnesota 55337

Civil & Municipal Engineering • Real Estate • Land Surveying • Land Planning

Certificate of Survey for OAKCREST HOMES, INC.


281 DENNISON AVE

Denotes proposed finished ground
 elevation at house = 923.00



O.K. TO USE
 Jan/R

FILE

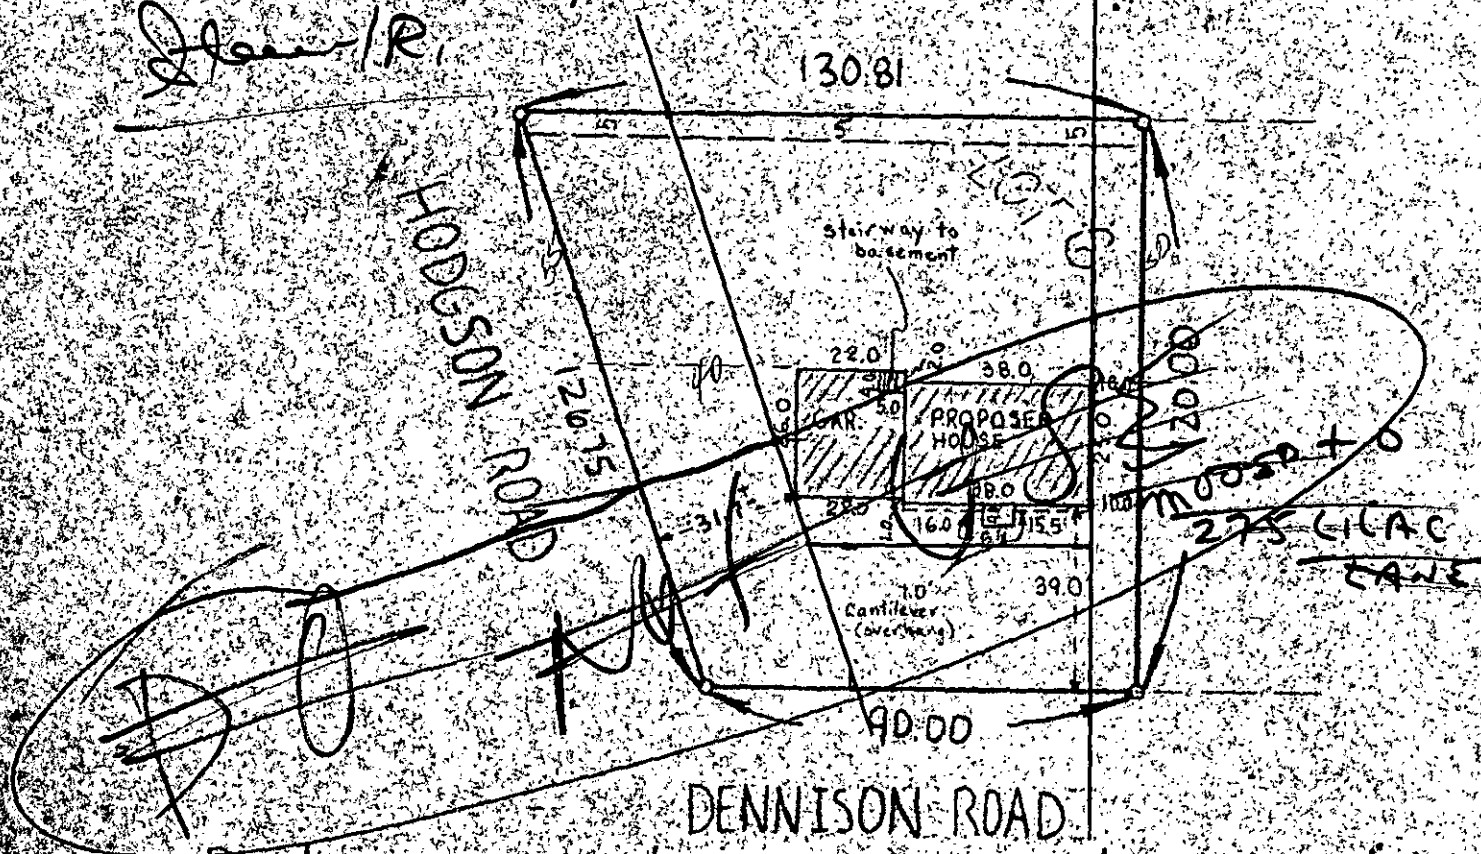

o Denotes iron monument

--- Denotes Drainage & Utility Easement

LOT 6, BLOCK 2
ROBERTS WINDWARD HEIGHTS NO. 1
 RAMSEY COUNTY

I hereby certify that this is a true and correct representation of a survey of the boundaries of the above described land, and of the location of all buildings thereon, and all visible encroachments, if any, from or on said land. As surveyed by me this day of MAY, A.D. 1977.

Scale: 1 inch = 40 feet

SUBURBAN ENGINEERING, INC.
 Engineers Surveyors
 by E. A. [Signature]