

FROM THE OFFICE OF

CHARLES O. GEORGI COMPANY

2215 West County Road B

Saint Paul, Minnesota 55113

REGISTERED CIVIL ENGINEER AND LAND SURVEYOR

**Certificate
of Survey**

I Heroby Certify that this plat shows a survey made by me of the property described on this plat, and that the corners are correctly placed as shown, and that all locations have been correctly shown.

CD District No. 8
Parcel No 104-C
Area 6,893 sq. ft. m.o.l.

Surveyed For Housing Authority

Date July 1977


Scale 1" = 40'

By *Charles O. Georgi*
REGISTERED LAND SURVEYOR

Description:

Lot 9, Block 1
Selby, McClung and Van Meter's Addition
Ramsey County, Minnesota.

MARSHALL AVE.

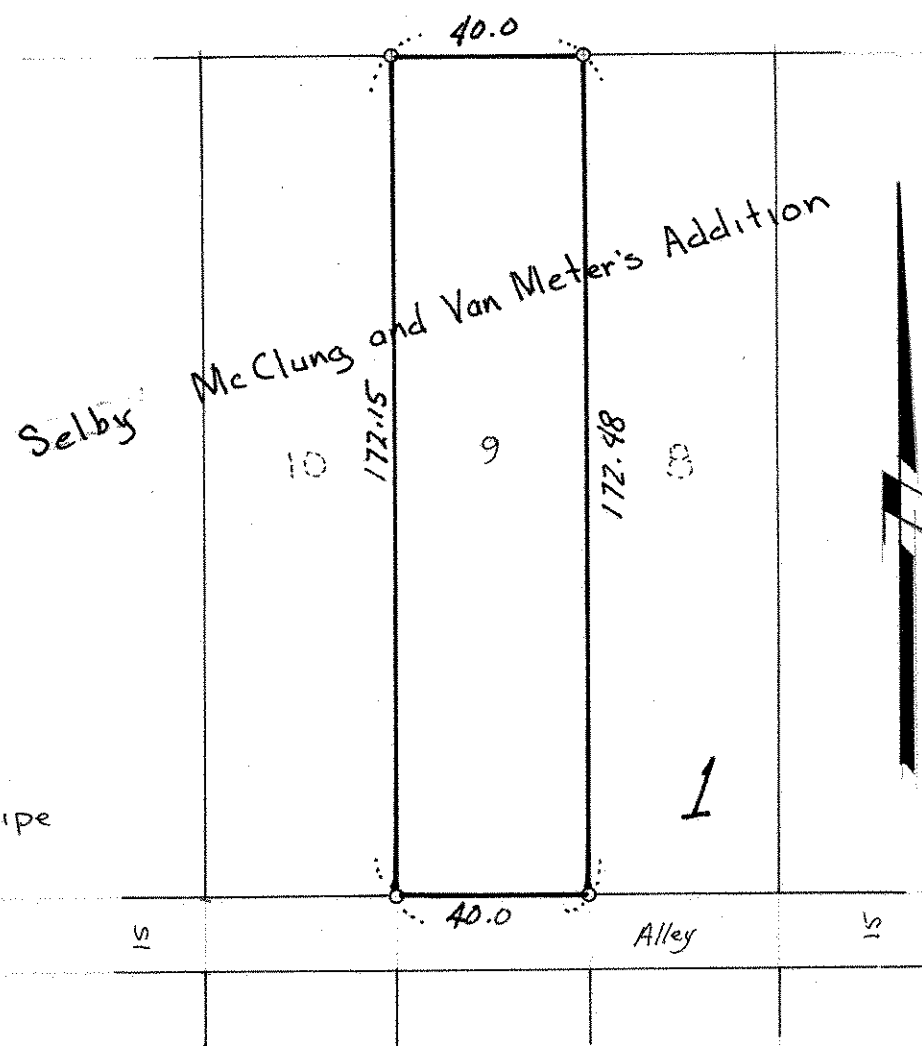

o Denotes iron pipe monument.