NW 1 28 23

FROM THE OFFICE OF

CHARLES O. GEORGI COMPANY

2215 West County Road B Saint Paul, Minnesota 55113

REGISTERED CIVIL ENGINEER AND LAND SURVEYOR

Certificate of Survey

C.D. District #8
Parcel 166-C
Area: 7194 Sq Ft. m.o.l.

I Hereby Certify that this plat shows a survey made by me of the property described on this plat, and that the corners are correctly placed as shown, and that all locations have been correctly shown.

Surveyed For Housing Authority
Date Oct. 1977
Scale 1" = 40'

By Charles O. Georgi
REGISTERED LAND SURVEYOR

Description:
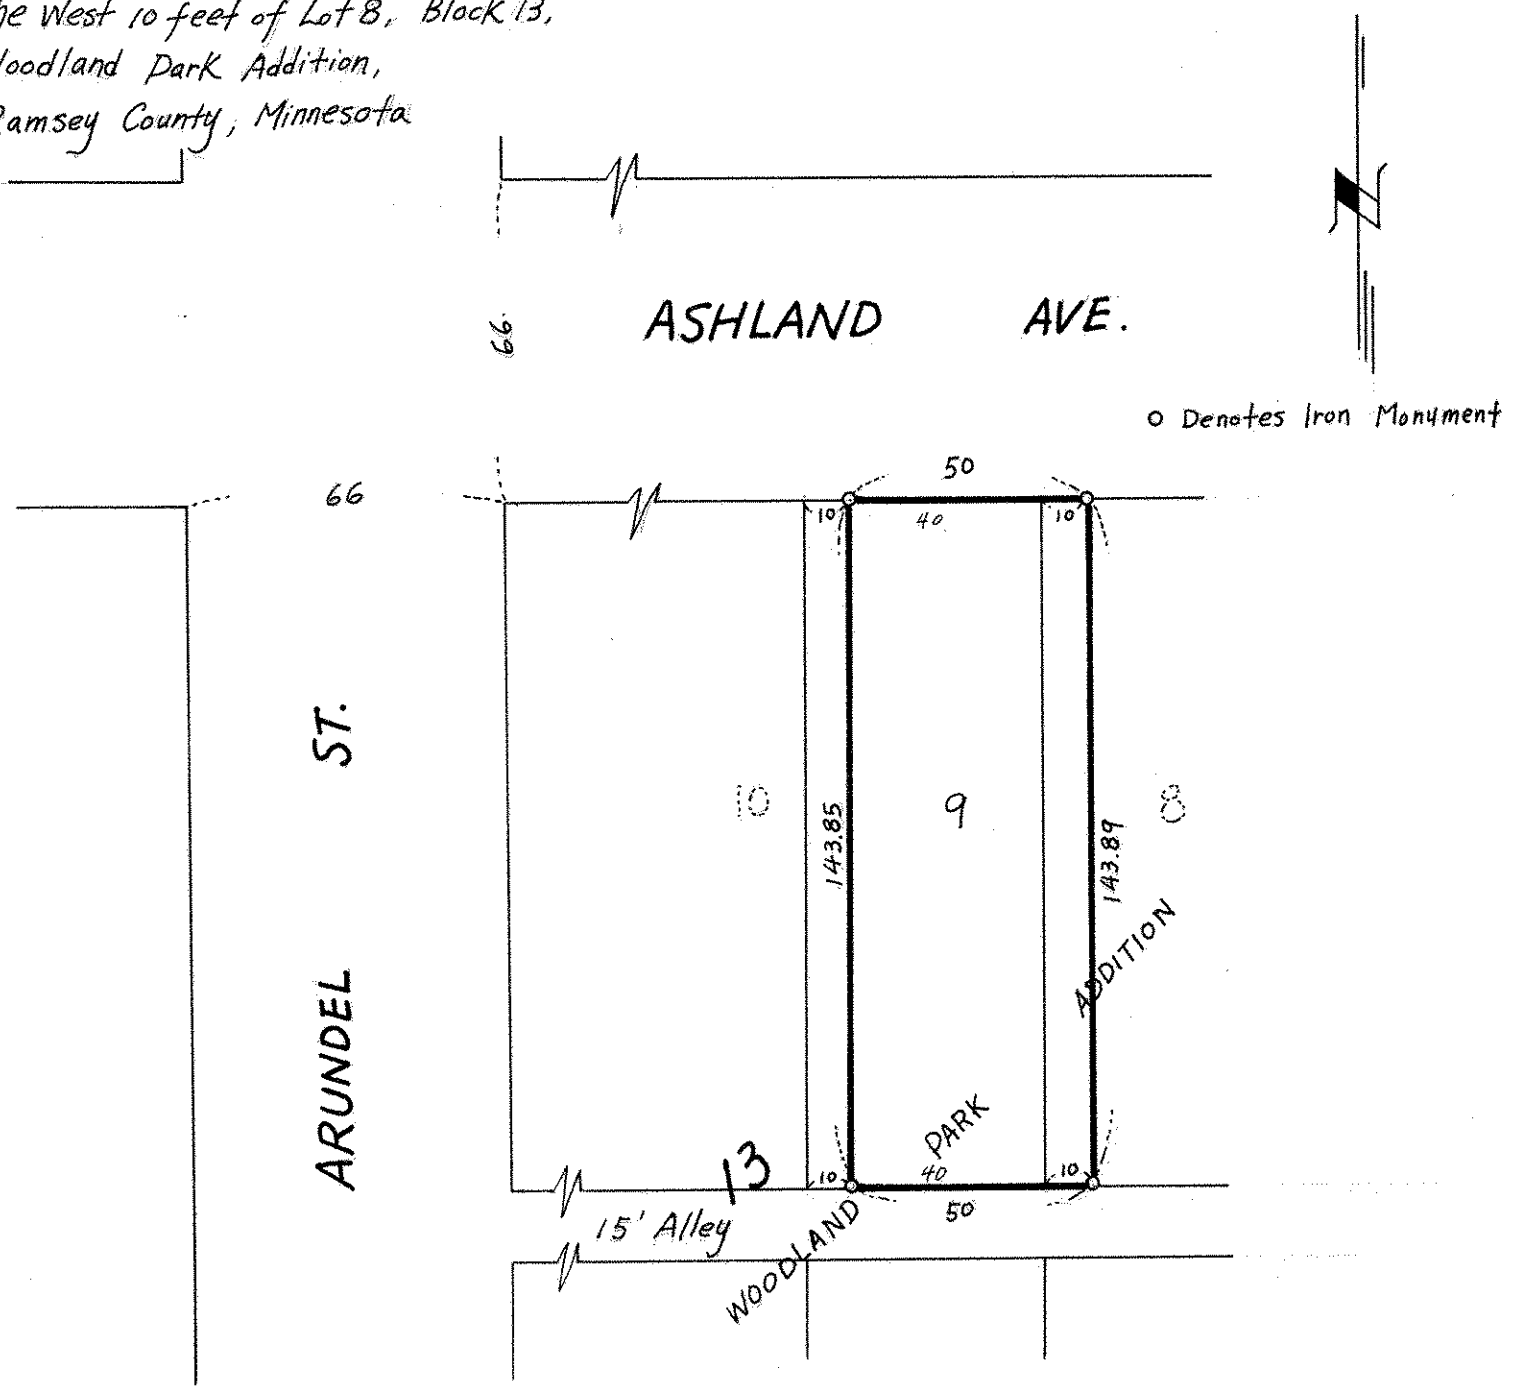
The East 40 feet of Lot 9 &
the West 10 feet of Lot 8, Block 13,
Woodland Park Addition,
Ramsey County, Minnesota