NW 1 28 23

FROM THE OFFICE OF

CHARLES O. GEORGI COMPANY

2215 West County Road B Saint Paul, Minnesota 55113

REGISTERED CIVIL ENGINEER AND LAND SURVEYOR

Certificate of Survey

C.D. District # 8
Parcel No. 166-C1
Area: 7196 Sq.Ft., M.O.L

I Hereby Certify that this plat shows a survey made by me of the property described on this plat, and that the corners are correctly placed as shown, and that all locations have been correctly shown.

Surveyed For Housing Authority

Date Oct. 1977

Scale 1" = 40'

By Charles O. Georgi
REGISTERED LAND SURVEYOR

Description:
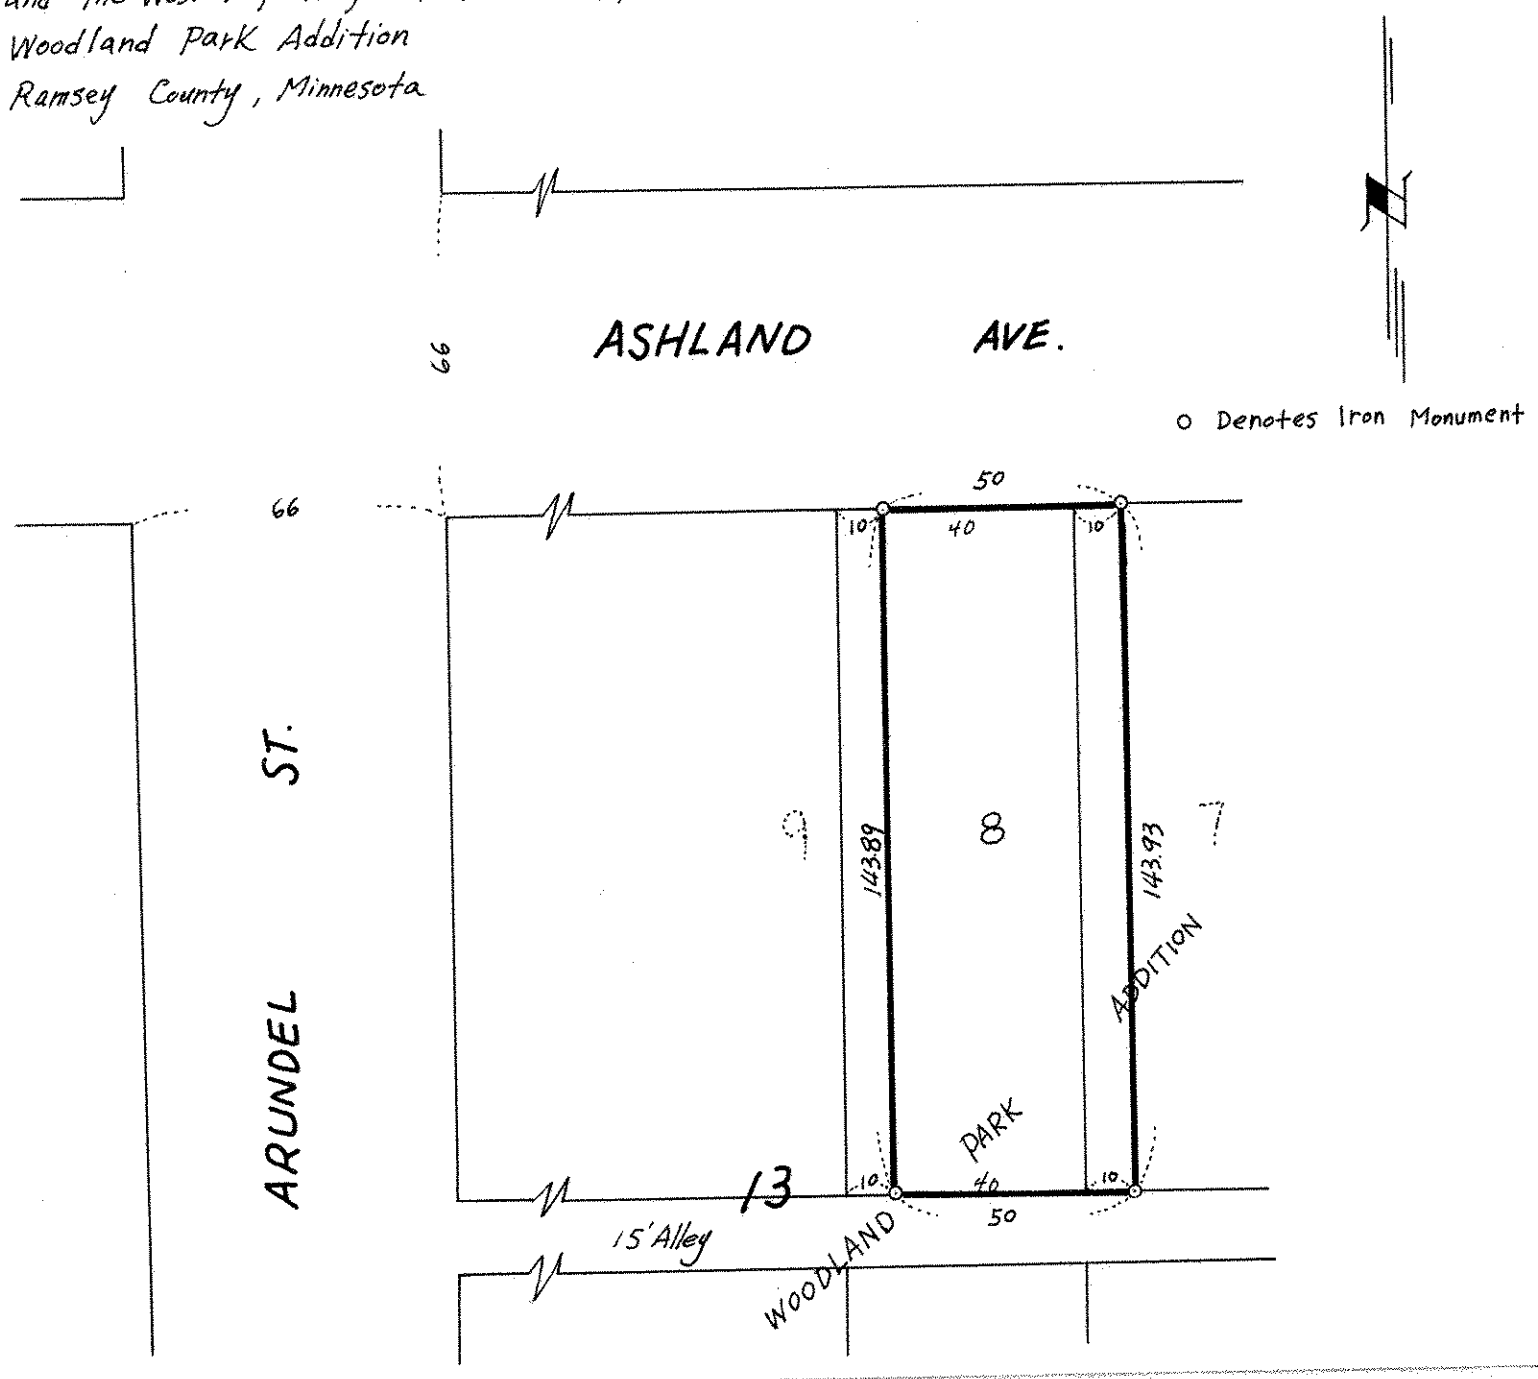
Lot 8 except the West 10 feet and the West 10 feet of Lot 7, Block 13, Woodland Park Addition Ramsey County, Minnesota