FROM THE OFFICE OF

Certificate of Survey

(D District No. 8 Parcel No. 140-A Area 8,639 sq.ft.m.o.l.

Description: Lot 14. Block 6,

CHARLES O. GEORGI COMPANY


2215 West County Road B

RECEITERED CIVE ENGINEER AND LAND SURVEYOR

I Hereby Certify that this plat shows a survey made by me of the property described on this plat, and that the corners are correctly placed as shown, and that all locations have been correctly shown.

Surveyed For Housing Authority

Dase Suly 1977

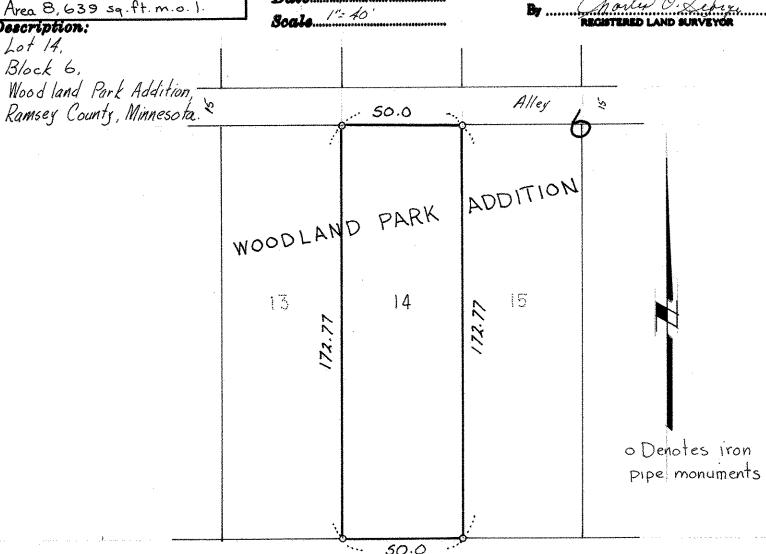

AVE. LAUREL