NW 10 29 22

FROM THE OFFICE OF

CHARLES O. GEORGI COMPANY

2215 West County Road B Saint Paul, Minnesota 55113

REGISTERED CIVIL ENGINEER AND LAND SURVEYOR

Certificate of Survey

I Hereby Certify that this plat shows a survey made by me of the property described on this plat, and that the corners are correctly placed as shown, and that all locations have been correctly shown.

Surveyed For Hughes Construction

Date February 1978

Scale 1"=100'

By Donald W Schmidt

REGISTERED LAND SURVEYOR

Description:

The South 80.0 feet of the North 771.0 feet of the West 725.0 feet of the West 1/2 of the NW 1/4 of Section 10, T29N, R22 W. Subject to Clarence Street.
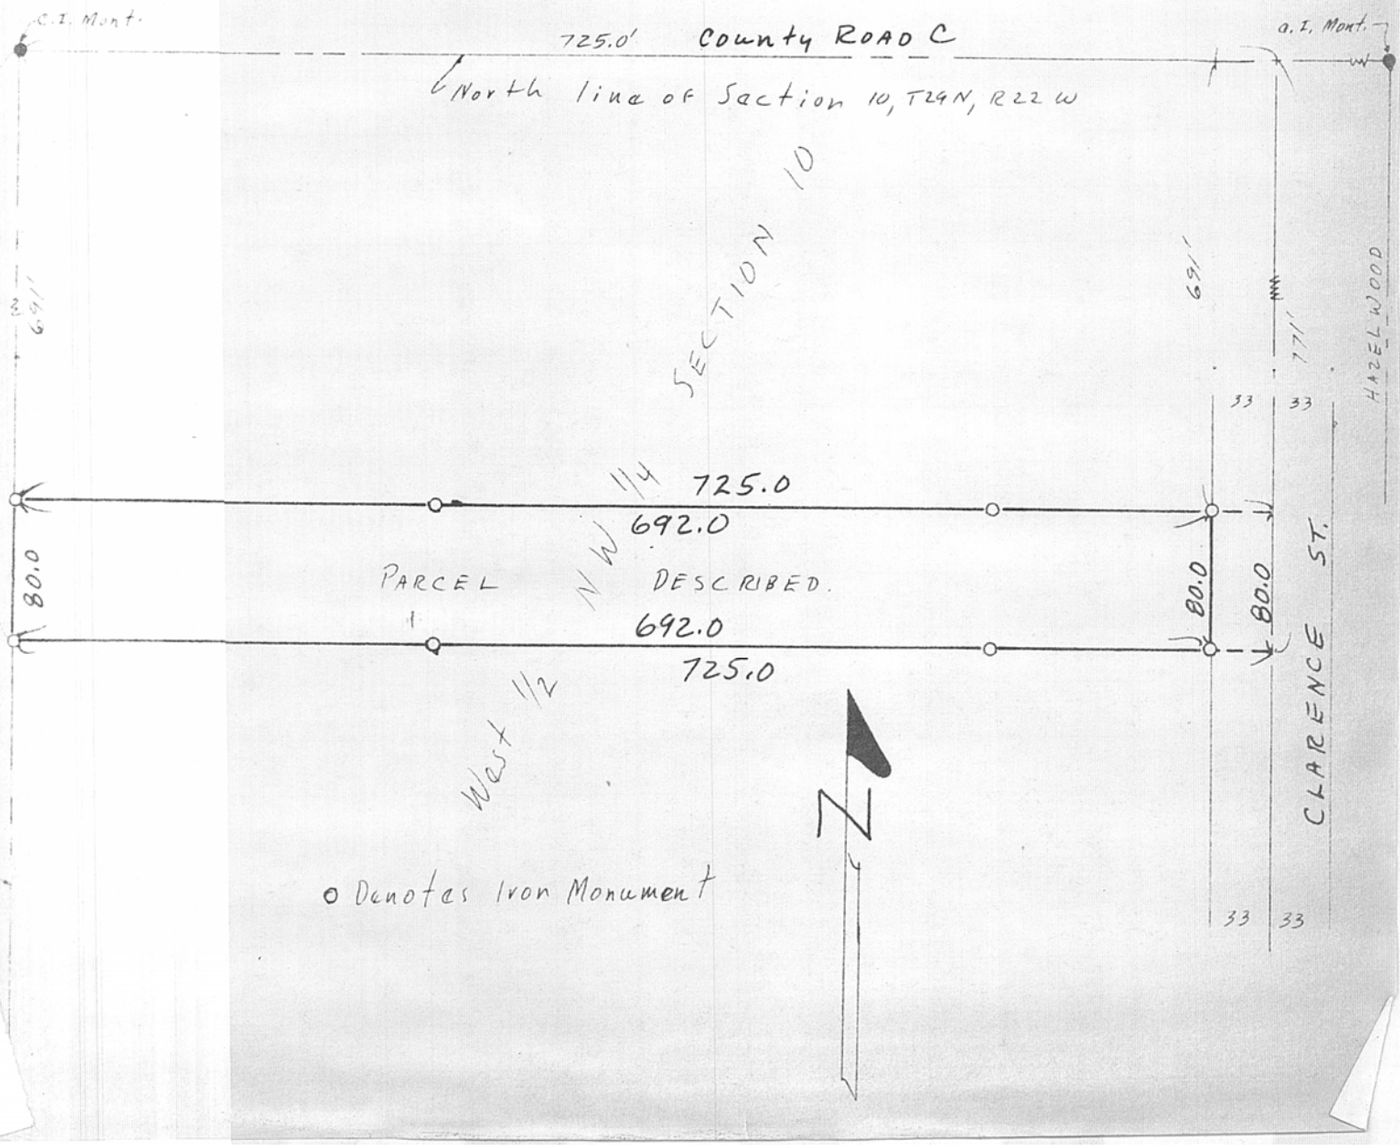
Ramsey County, Minnesota