


18th 4th AVE, S.E.
ST. CLOUD, MN 56301
612-251-7751

314 OAK ST.
SAUK CENTRE, MN 56378
612-352-3664

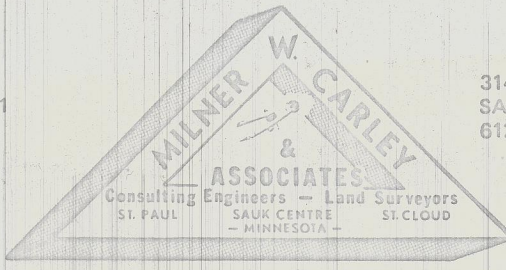


500 W. HWY. 96, ST. PAUL, MN 55112 612-484-3801

I hereby certify that this Certificate of Survey Description Easement Plan Specification or Building Location was prepared by me or under my direct supervision and that I am a duly Registered Land Surveyor under the laws of the State of Minnesota.

Le Roy H. Wimmer

Reg. No. 4987 Date 1-17-78

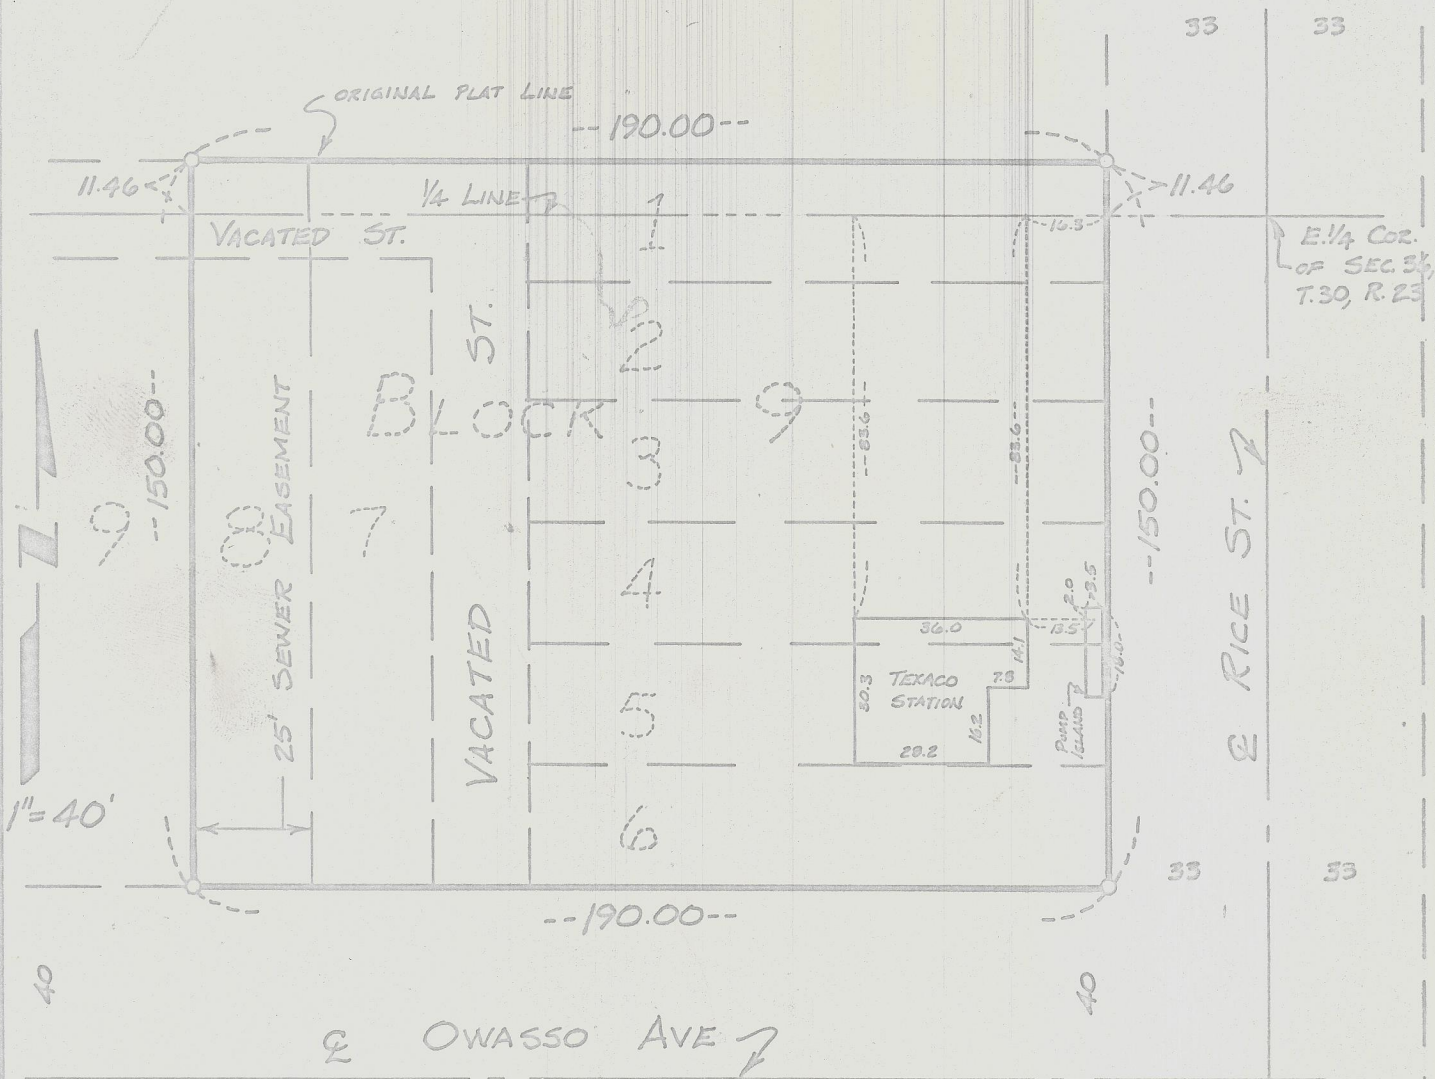

Lots 1, 2, 3, 4, 5, 6, 7 and 8, Block 9, Owasso, Ramsey County, Minnesota and vacated streets.

77-543
535-38

L 5940