FROM THE OFFICE OF

## Certificate of Survey

Lot 7, Block 2 Josephine Hills Ramsey County, Minn

Description:

## **CHARLES O. GEORGI COMPANY**

2215 West County Road B

Saint Paul, Minnesota 55113

REGISTERED CIVIL ENGINEER AND LAND SURVEYOR

I Hereby Certify that this plat shows a survey made by me of the property described on this plat, and that the corners are correctly placed as shown, and that all locations have been correctly shown.

Surveyed For Michels Const


Date May 1978

Scale | | "= 50"

By REGISTERED LAND SURVEYOR

o Denotes Iron Pipe Monument.

· Iron found in place

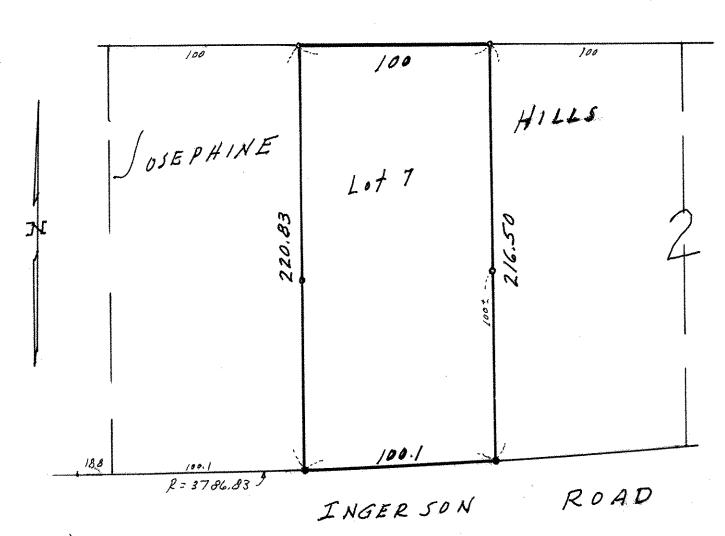

6

R=1113.287

TO INGERSON COURT