NW 11 30 23

# Certificate of Survey

FROM THE OFFICE OF

## CHARLES O. GEORGI COMPANY

2215 West County Road B  Saint Paul, Minnesota 55113

REGISTERED CIVIL ENGINEER AND LAND SURVEYOR

*I Hereby Certify that* this plat shows a survey made by me of the property described on this plat, and that the corners are correctly placed as shown, and that all locations have been correctly shown.

***Surveyed For*** Ernie Burrows

***Date*** March 1978

***Scale*** 1"=60'

By Charles O. Georgi
REGISTERED LAND SURVEYOR

*Description:*

Lot 9, Block 1, Birchwood Homesites

Ramsey County, Minn.

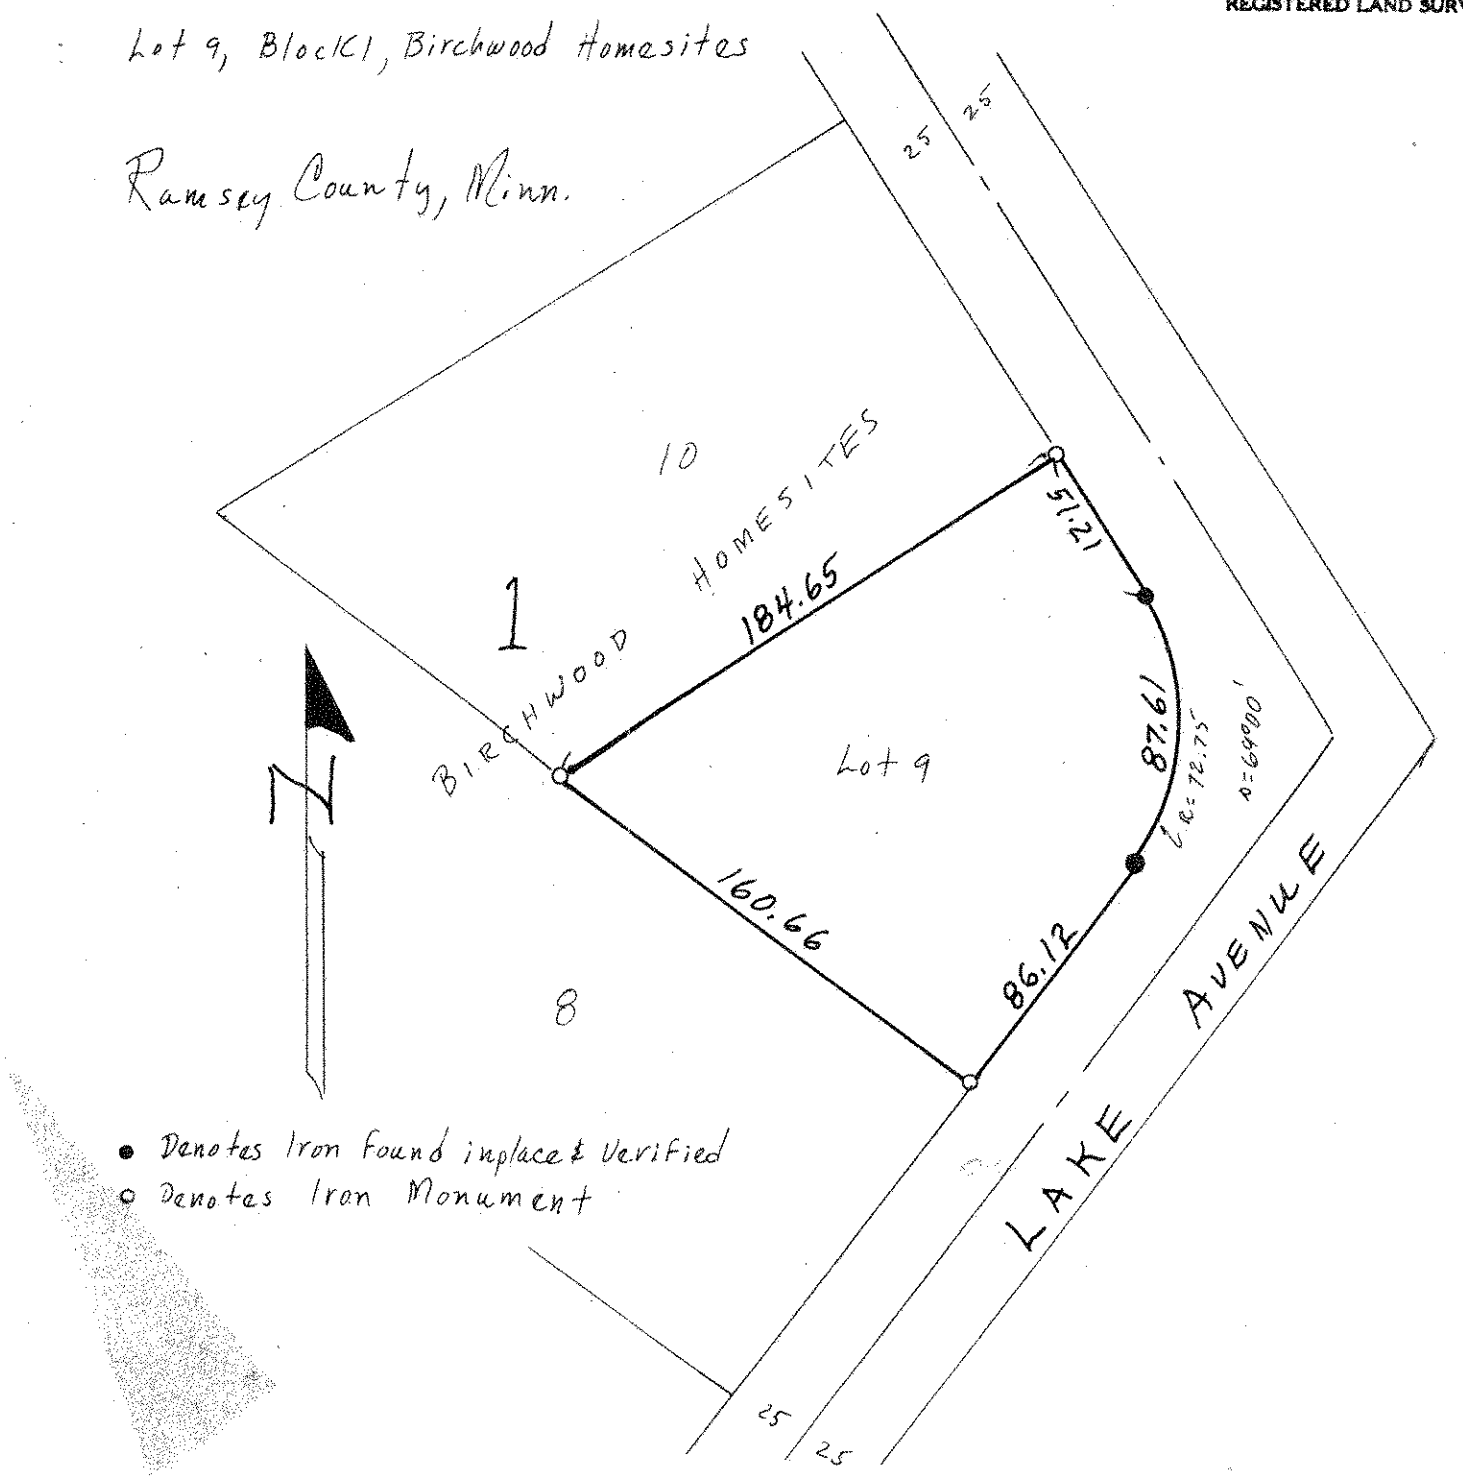


● Denotes Iron Found inplace & Verified

○ Denotes Iron Monument