NW 13 3023

Certificate of Survey

FROM THE OFFICE OF

CHARLES O. GEORGI COMPANY

2215 West County Road B Saint Paul, Minnesota 55113

REGISTERED CIVIL ENGINEER AND LAND SURVEYOR

I Hereby Certify that this plat shows a survey made by me of the property described on this plat, and that the corners are correctly placed as shown, and that all locations have been correctly shown.

Jack Krongard - 5/3/78 Added location of House Fdn.

Surveyed For Wally Coppersmith

Date April 1978

Scale 1" = 50'

By Charles O. Georgi
REGISTERED LAND SURVEYOR

Description:

Lot 2, Block 2,
Forsberg Turtle Lake Heights
Ramsey County, Minn.

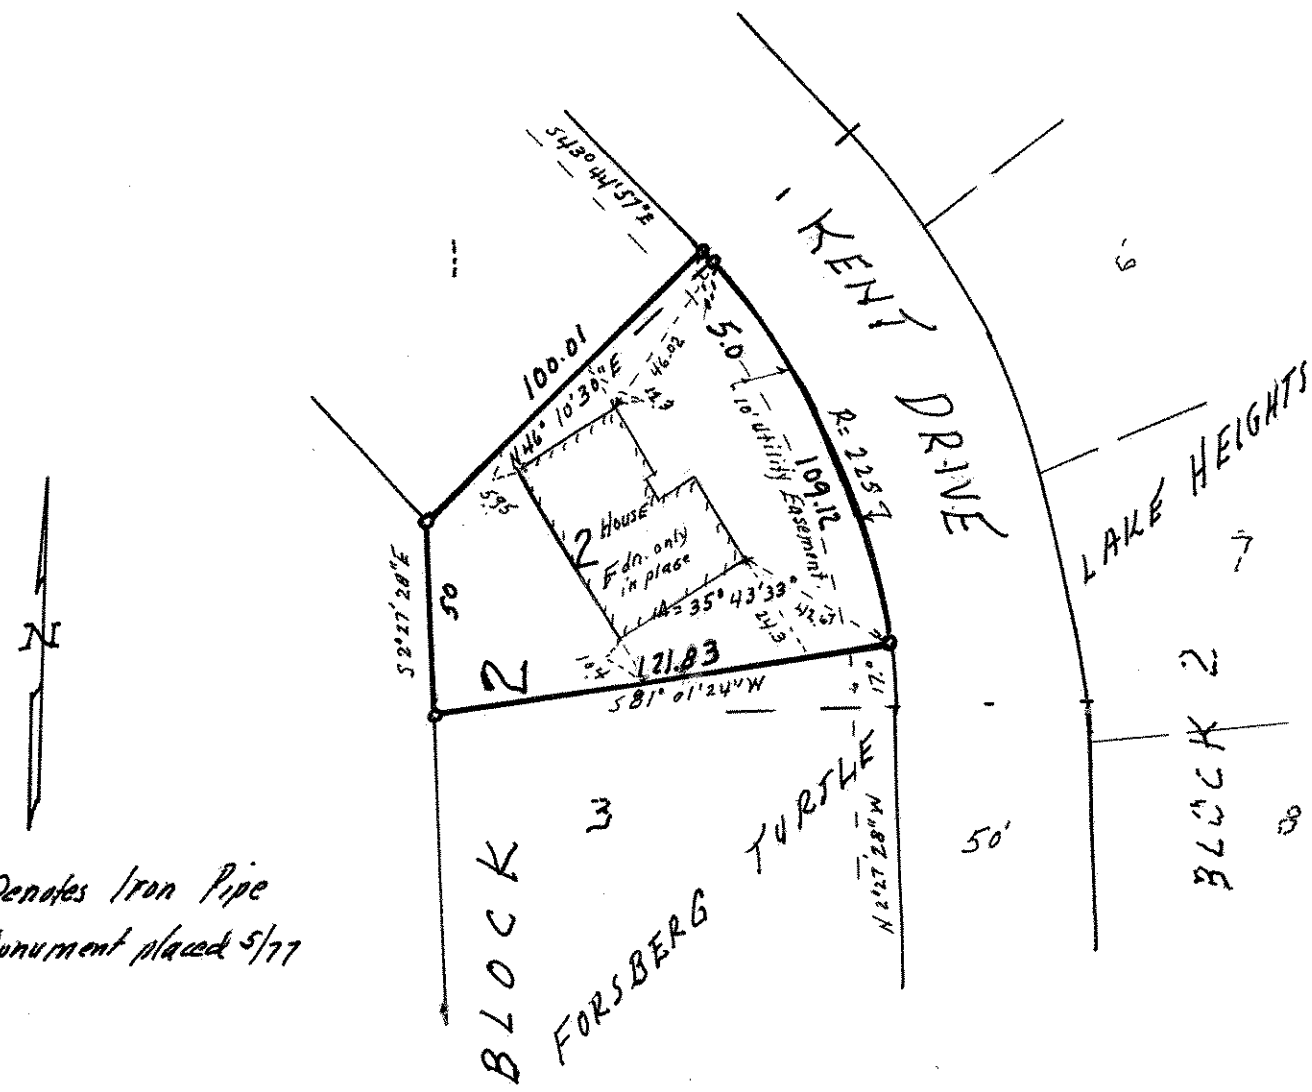

o Denotes Iron Pipe Monument placed 5/77