Certificate of Survey

From the office of

GEORGI- SCHMIDT & ASSOC. INC.

3092 No. Lexington Ave., Roseville, Mn. 55113 LAND SURVEYING 483-4408

I Hereby Certify that this plat shows a survey made by me of the property described on this plat, and that the corners are correctly placed as shown, and that all locations have been correctly shown.


Surveyed For Edmund Mokrzycki

Date October 1978

By REGISTERED LAND SURVEYOR

Description:

The West 1/2 of lot14 and all of lot 15, Block 3, Jaggard's Addition, Ramsey County Minnesota

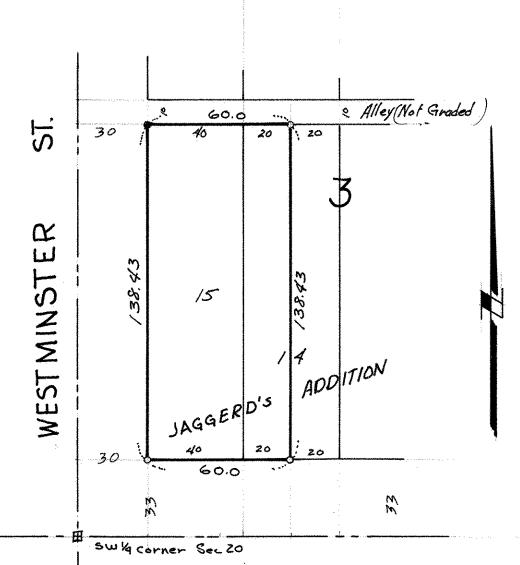

- o Denotes iron pipe monument
- · Denotes iron pipe monument found in place

MARYLAND AVE.