NE 4-29-22

Certificate of Survey

From the office of

GEORGI- SCHMIDT & ASSOC. INC.

3092 No. Lexington Ave., Roseville, Mn. 55113

LAND SURVEYING

483-4408

I Hereby Certify that this plat shows a survey made by me of the property described on this plat, and that the corners are correctly placed as shown, and that all locations have been correctly shown.

Job Number: 455

Surveyed For Jean Parranto

Date 11/30/79

Scale 1"=100'

By Donald W. Schmidt

REGISTERED LAND SURVEYOR

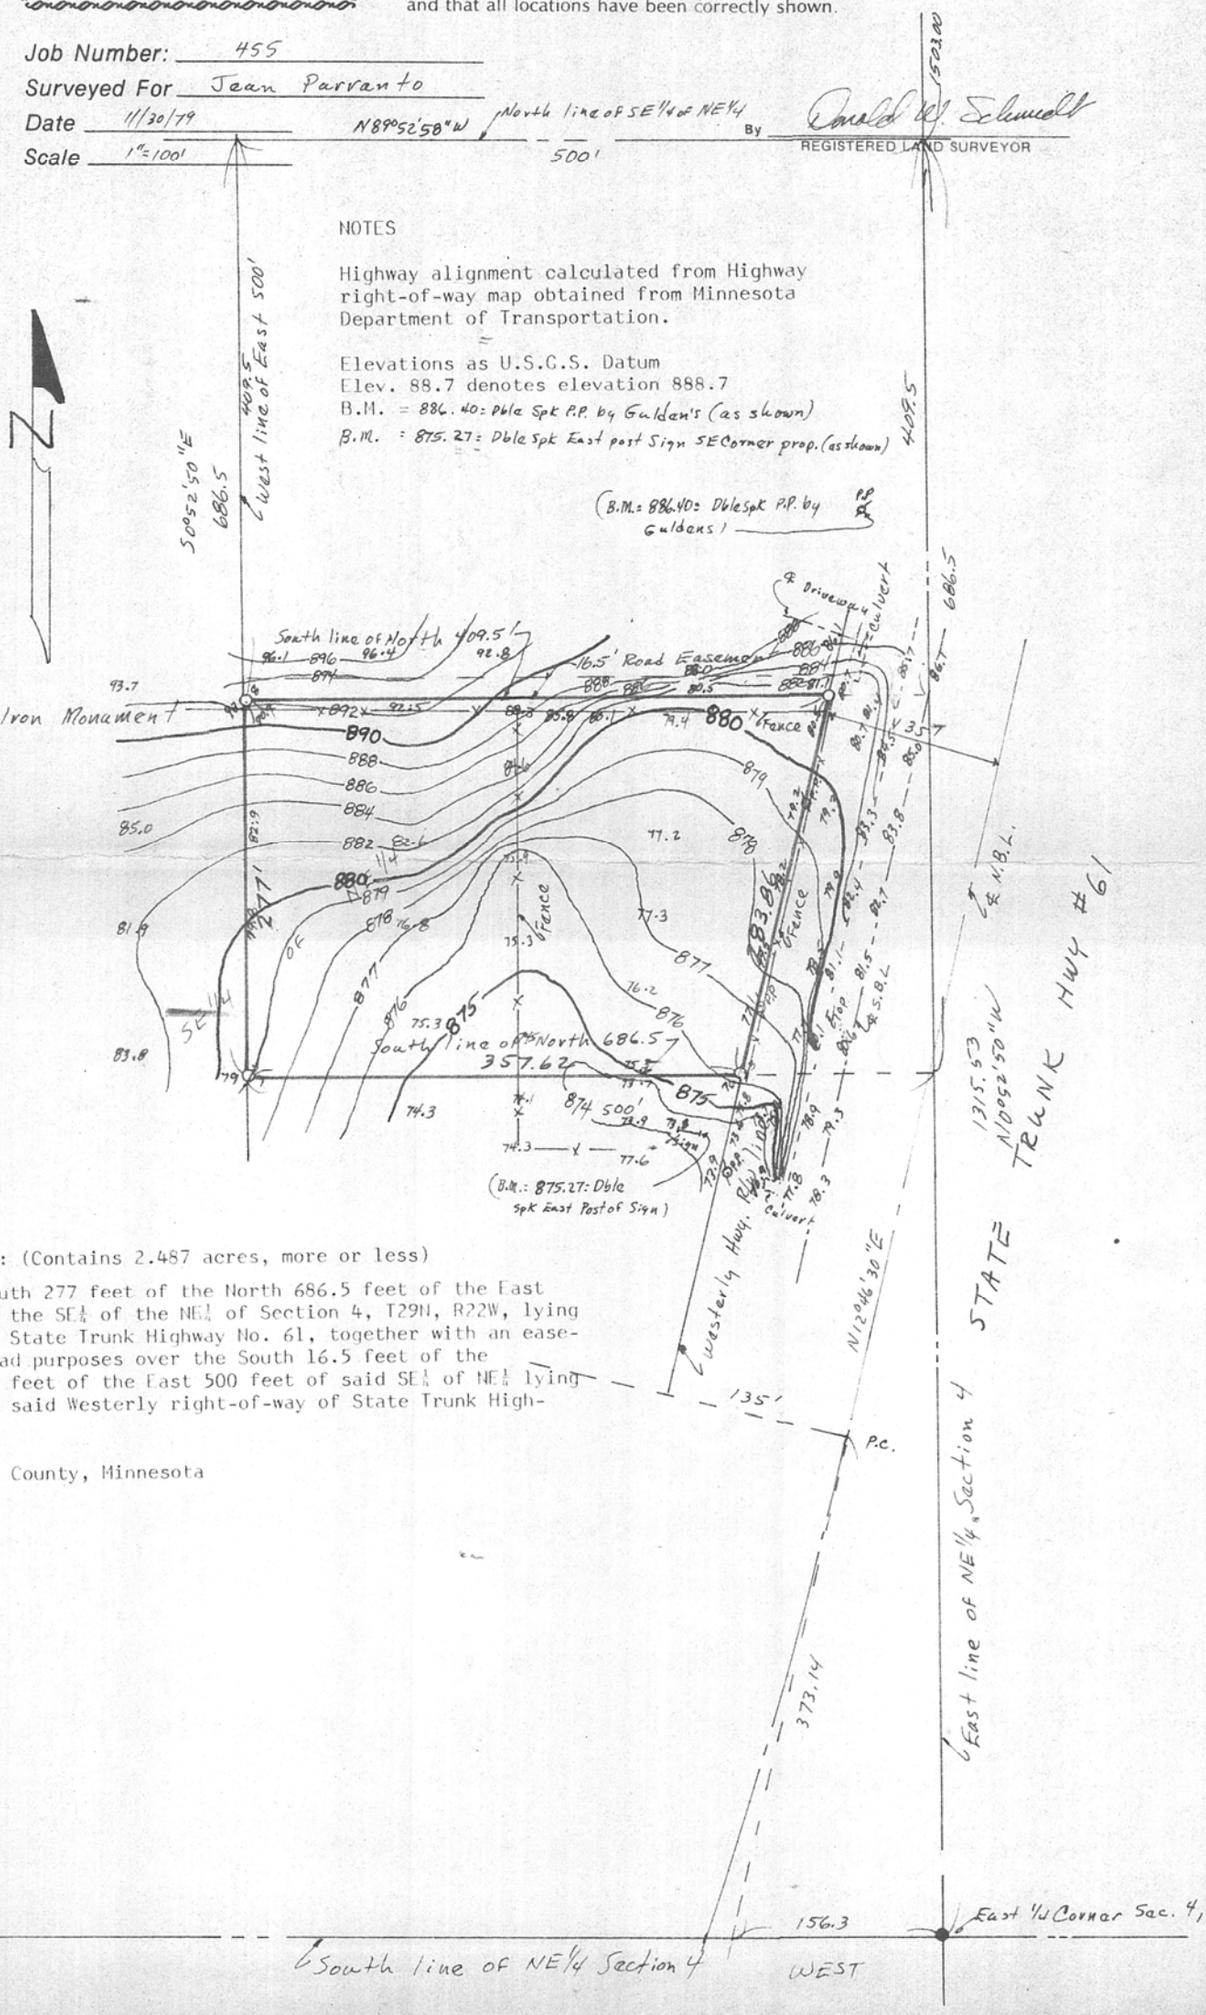

DESCRIPTION: (Contains 2.487 acres, more or less)

The South 277 feet of the North 686.5 feet of the East 500 feet of the SE¼ of the NE¼ of Section 4, T29N, R22W, lying westerly of State Trunk Highway No. 61, together with an easement for road purposes over the South 16.5 feet of the North 409.5 feet of the East 500 feet of said SE¼ of NE¼ lying Westerly of said Westerly right-of-way of State Trunk Highway No. 61.

Ramsey County, Minnesota