SW 12 29 23

Certificate of Survey

From the office of

GEORGI- SCHMIDT & ASSOC. INC.

3092 No. Lexington Ave., Roseville, Mn. 55113

LAND SURVEYING

483-4408

I Hereby Certify that this plat shows a survey made by me of the property described on this plat, and that the corners are correctly placed as shown, and that all locations have been correctly shown.

Job Number: 503

Surveyed For Church of God

Date 10/15/79

Scale ~~1"=60'~~ 1"=50 By Donald W. Schmidt

REGISTERED LAND SURVEYOR

DESCRIPTION:

The West 85 feet of the North 180 feet of the West ½ of the SW1/4 of the NE1/4 of the SW1/4 of Section 12,T29N,R23W.

Subject to Lovell Avenue.

Ramsey County, Minnesota

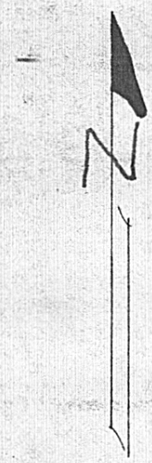

○ Danotes Iron Monument

DESCRIPTION:

The North 180 feet of the West½ of the SW¼ of the NE¼ of the SW¼ of Section 12,T29N,R23W, except the West 85 feet thereof.

Subject to Lovell Avenue, and subject to road easement over the East 25 feet thereof.
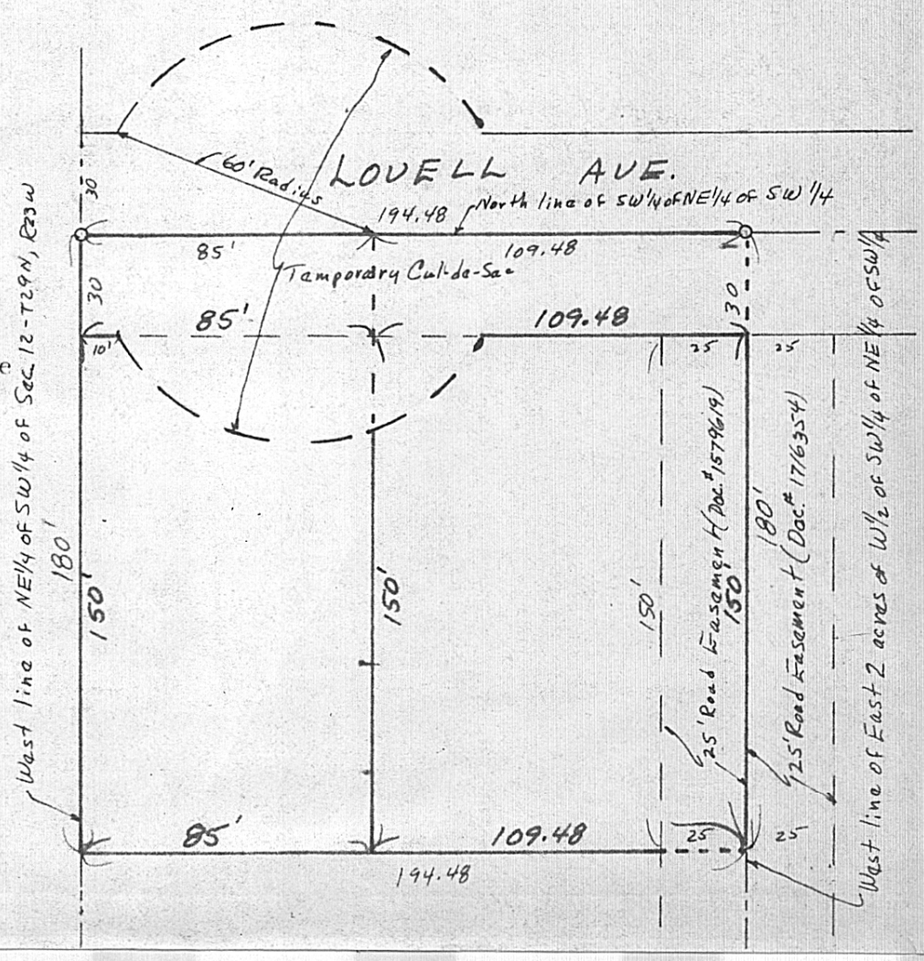
Ramsey County, Minnesota