NE 36 30 23

Certificate of Survey

From the office of

GEORGI- SCHMIDT & ASSOC. INC.

3092 No. Lexington Ave., Roseville, Mn. 55113

LAND SURVEYING

483-4408

I Hereby Certify that this plat shows a survey made by me of the property described on this plat, and that the corners are correctly placed as shown, and that all locations have been correctly shown.

Job Number: 517

Surveyed For BOB MICHELS

Date Oct. 1979

Scale 1" = 30'

By Donald W. Schmidt
REGISTERED LAND SURVEYOR

Description:
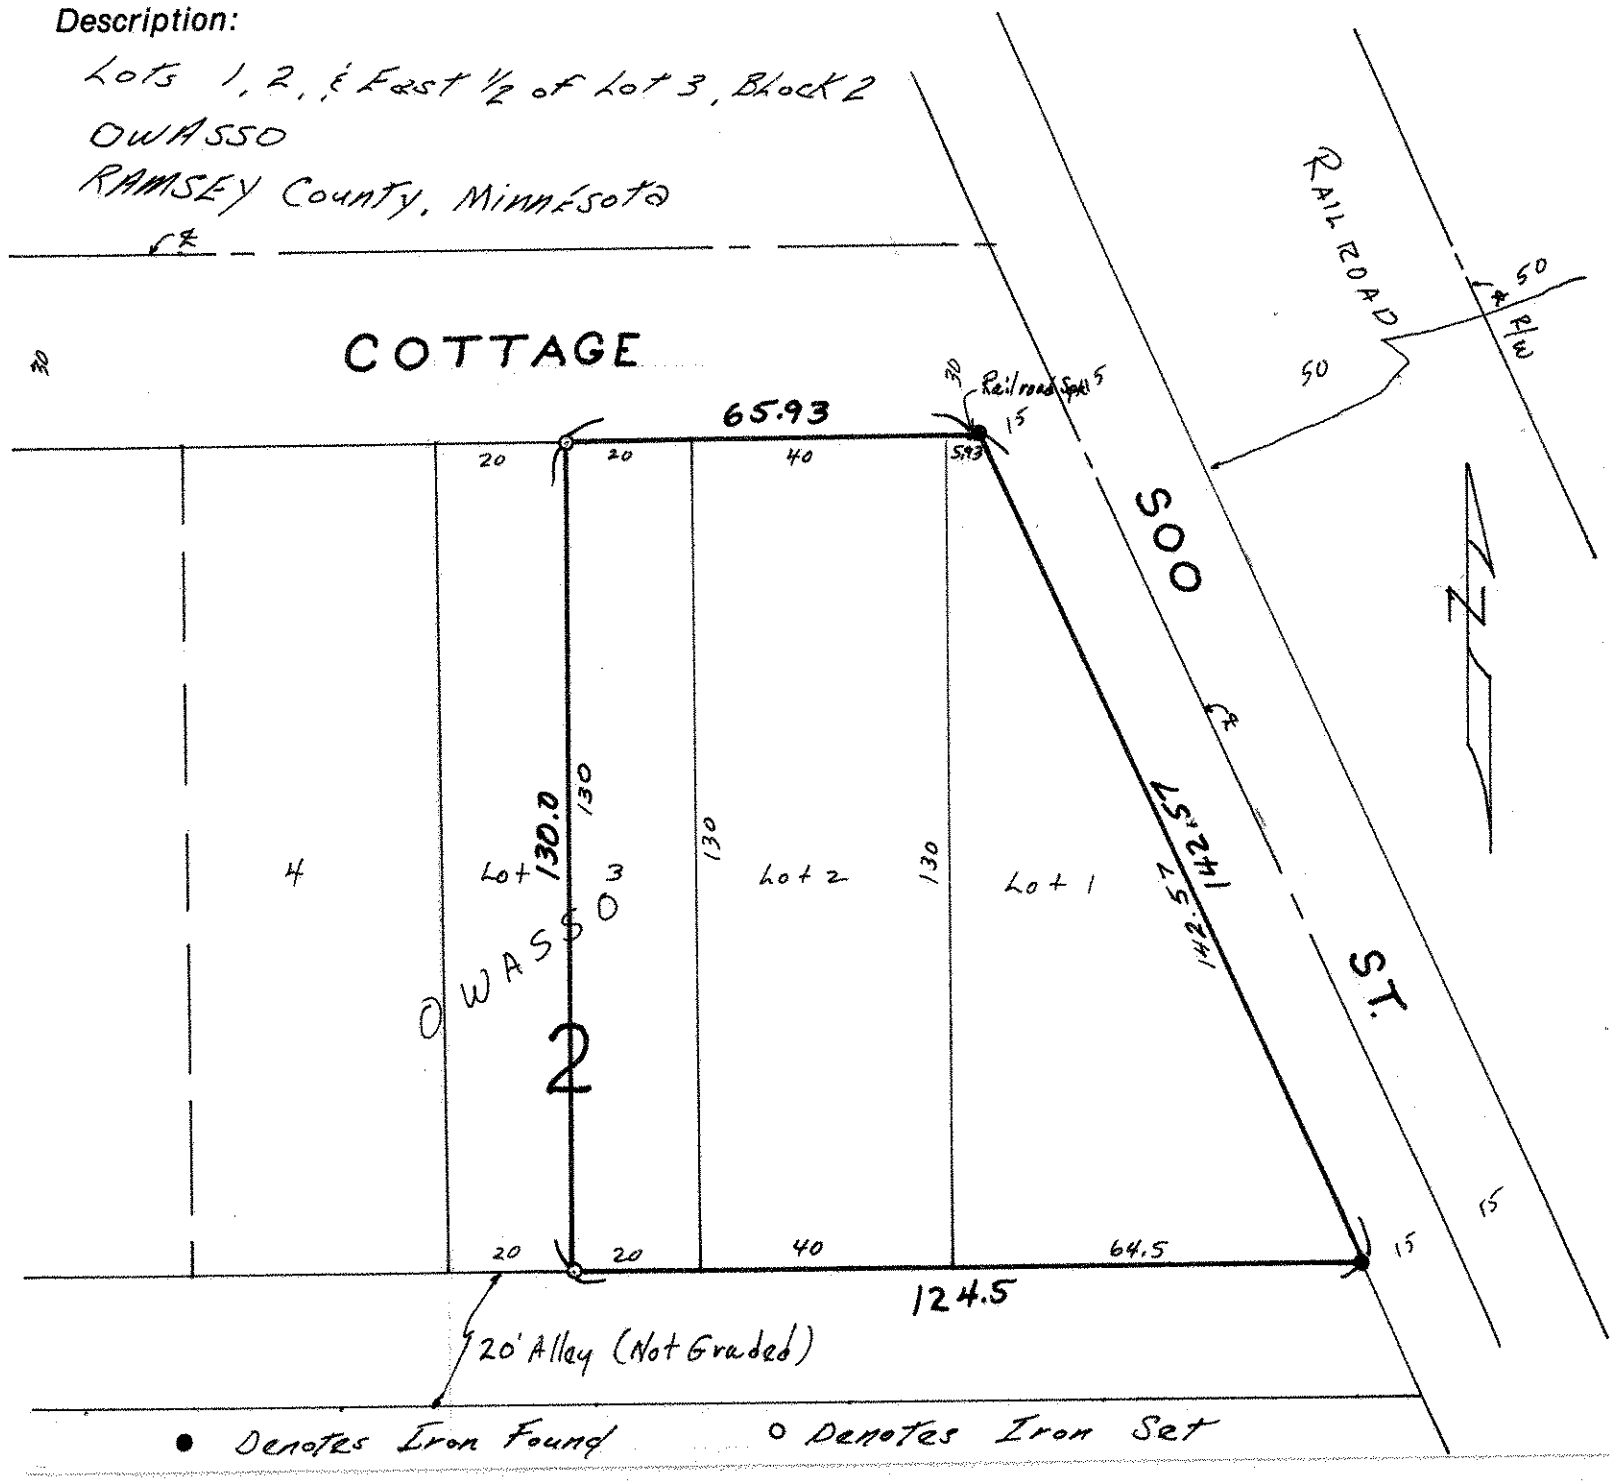
Lots 1, 2, & East ½ of Lot 3, Block 2
OWASSO
RAMSEY County, Minnesota