

Certificate
of Survey

From the office of
GEORGI-SCHMIDT & ASSOC. INC.
3092 No. Lexington Ave., Roseville, Mn. 55113
LAND SURVEYING
483-4408

I Hereby Certify that this plat shows a survey made by me of the property described on this plat, and that the corners are correctly placed as shown, and that all locations have been correctly shown.

Job Number: 369

Surveyed For Fran Pitkanen

Date June 1979



Scale 1" = 40'

By Arnold W. Schmidt
REGISTERED LAND SURVEYOR

Description:

Lot 9, Block 2, Lakeshore Oaks Addition #2

Ramsay County, Mn.

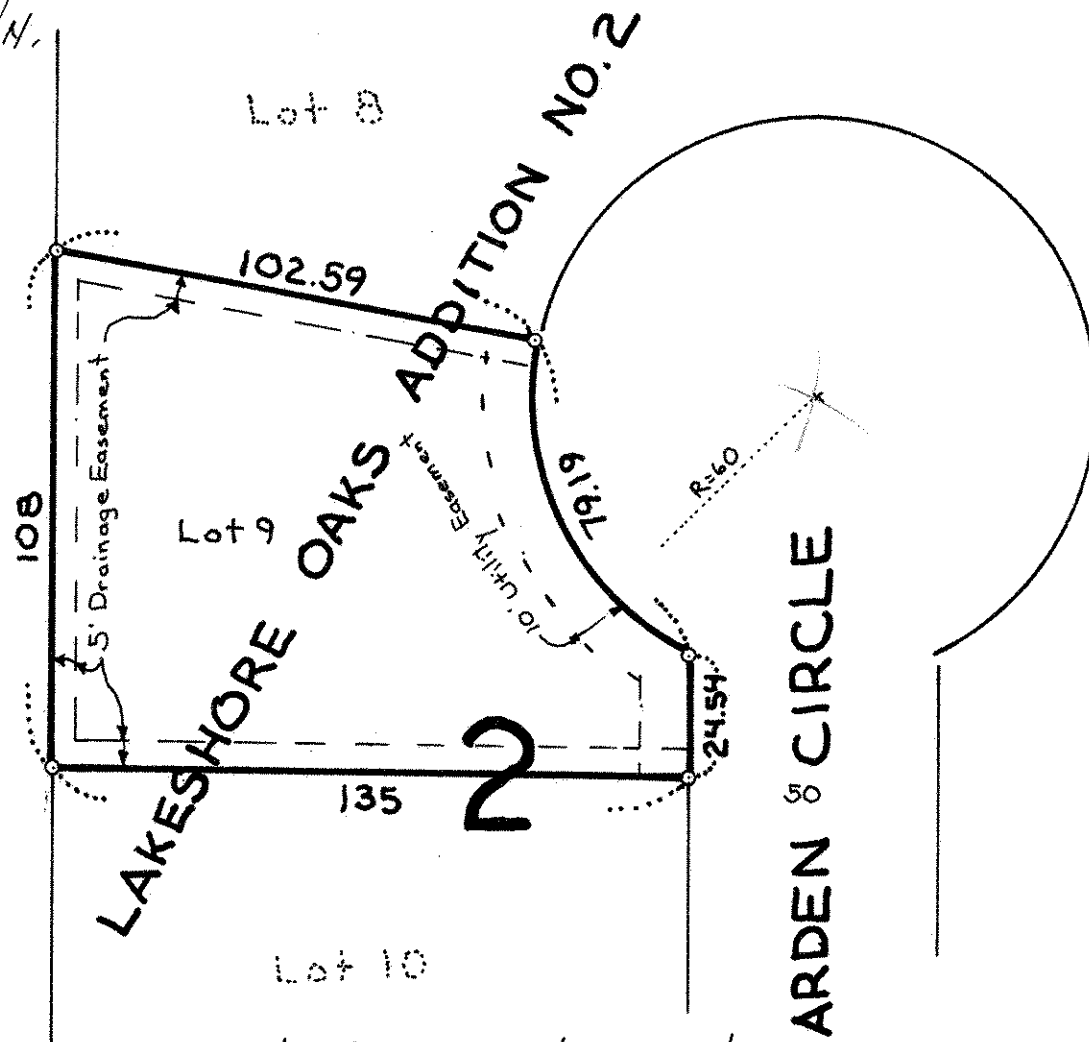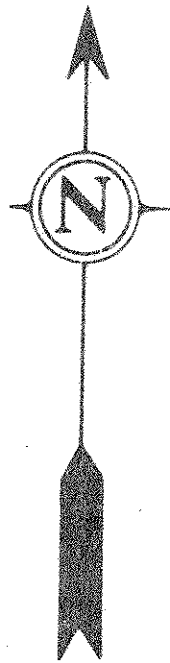

o Denotes Irons Placed Previously