Certificate of Survey

From the office of

GEORGI- SCHMIDT & ASSOC. INC.

3092 No. Lexington Ave., Roseville, Mn. 55113 LAND SURVEYING

483-4408


I Hereby Certify that this plat shows a survey made by me of the property described on this plat, and that the corners are correctly placed as shown, and that all locations have been correctly shown.

Surveyed For Gevald Brock Job Number: Date <u>August 16, 1979</u> Scale 1"= 401

Description:

Lot 11, Block 10, Shorewood Hills No. 2

Ramsay County, Minnesota

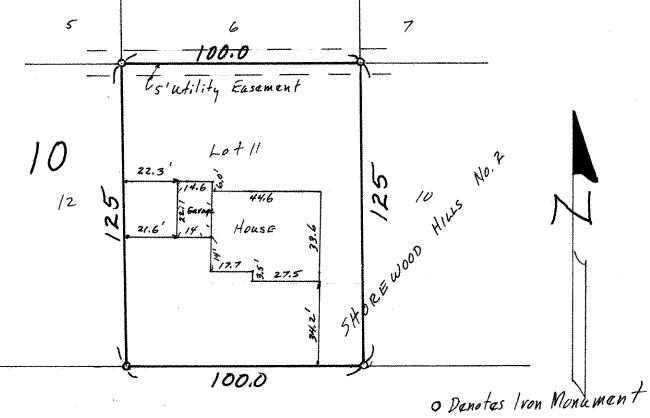

GLENVIEW

AVE.