NW 34 30 23

Certificate of Survey

From the office of

GEORGI- SCHMIDT & ASSOC. INC.

3092 No. Lexington Ave., Roseville, Mn. 55113

LAND SURVEYING

483-4408

I Hereby Certify that this plat shows a survey made by me of the property described on this plat, and that the corners are correctly placed as shown, and that all locations have been correctly shown.

Job Number: 350

Surveyed For Richard Gibbons

Date June 20, 1979

Scale 1" = 40'

By Donald W. Schmidt
REGISTERED LAND SURVEYOR

Description:

Lot 12,
Block 2,
Arden Hills,
Ramsey County, Mn.

* Surveyed in accordance with irons found inplace through out plat.

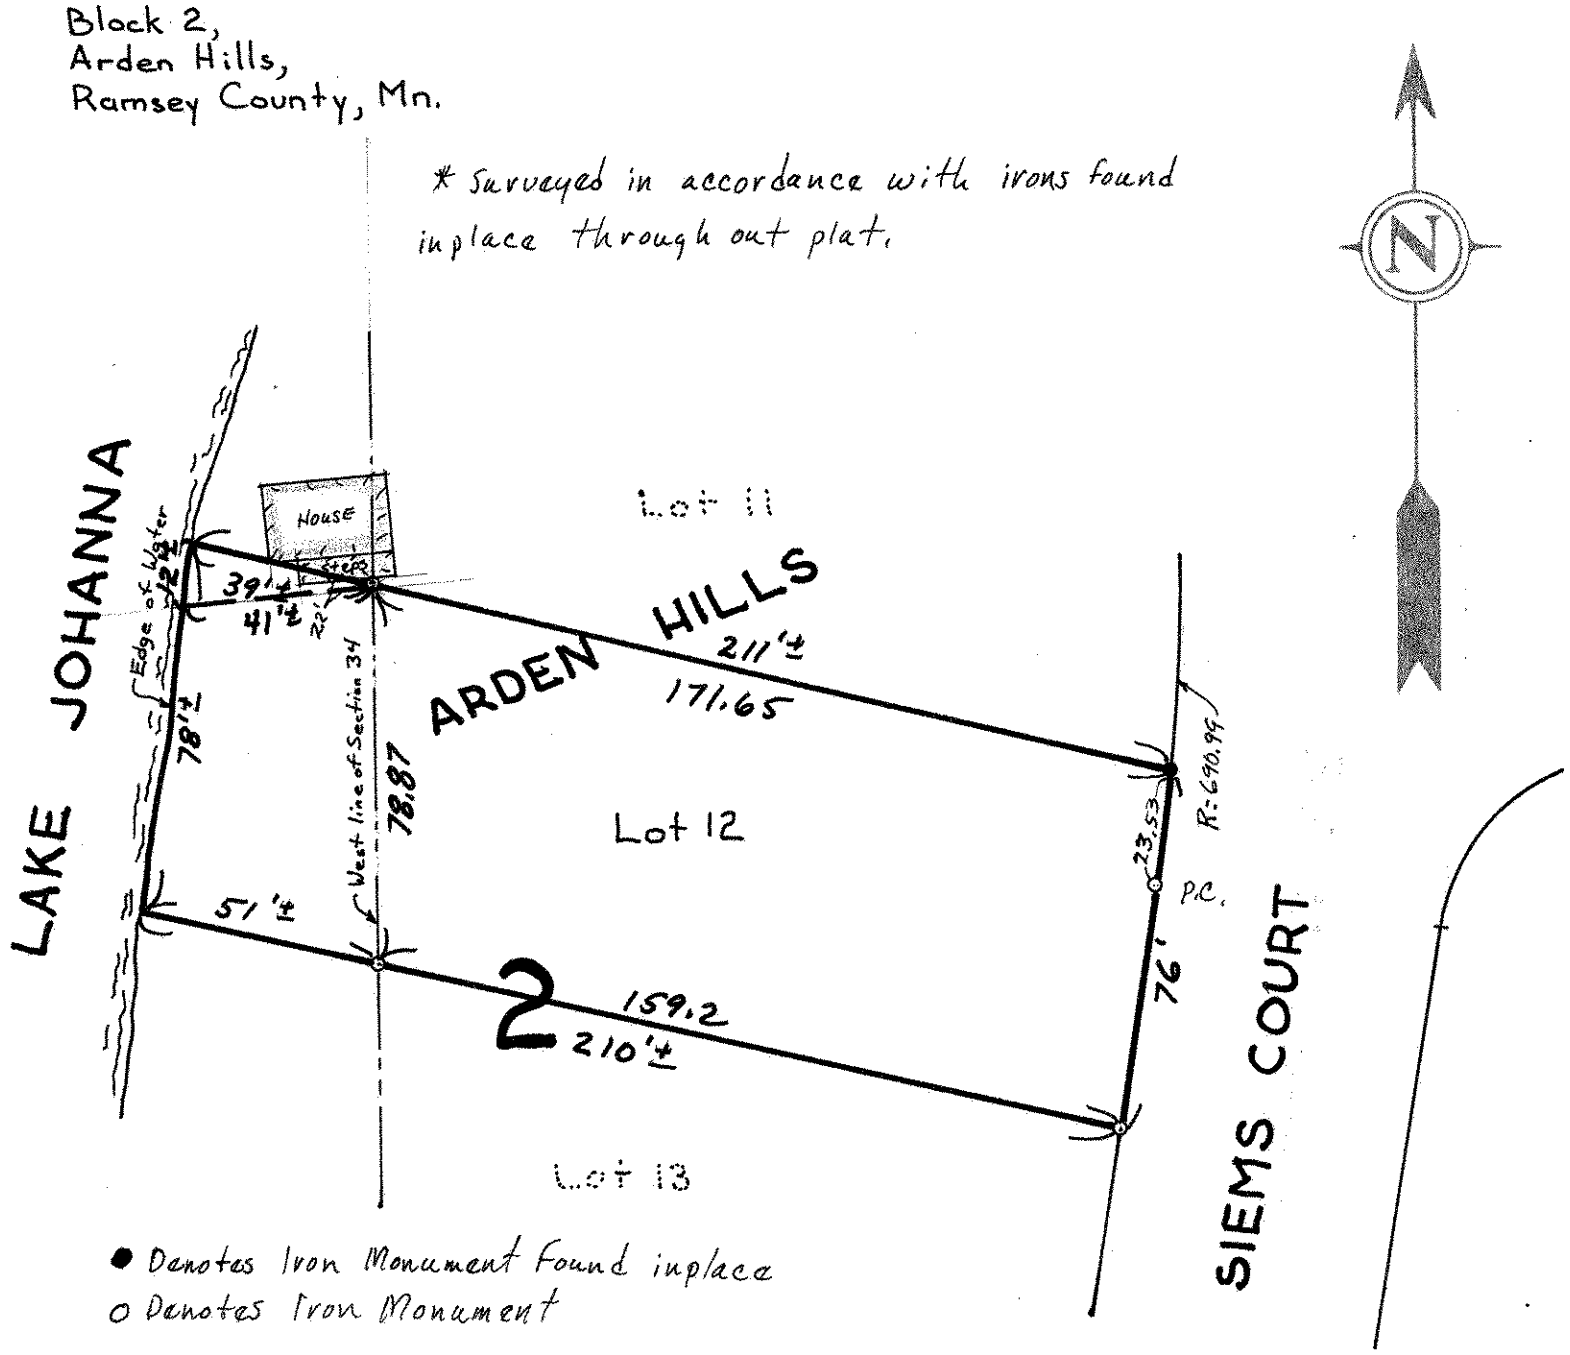

● Denotes Iron Monument Found inplace
o Denotes Iron Monument