

**Certificate
of Survey**

From the office of
GEORGI-SCHMIDT & ASSOC. INC.
 3092 No. Lexington Ave., Roseville, Mn. 55113
 LAND SURVEYING
 483-4408

I Hereby Certify that this plat shows a survey made by me of the property described on this plat, and that the corners are correctly placed as shown, and that all locations have been correctly shown.

Job Number: 460

Surveyed For Carroll Story



Date Aug 29, 1979

Scale 1" = 40'

By Donald W. Schmidt
 REGISTERED LAND SURVEYOR

Description:

The South 80.0 feet
 of the North 187.0
 feet of Lot 1, Block
 2, W.F. Krech's Add,
 Ramsey County,
 Minnesota.

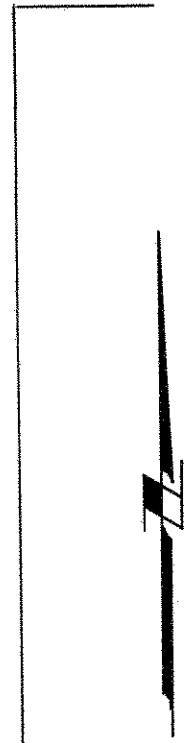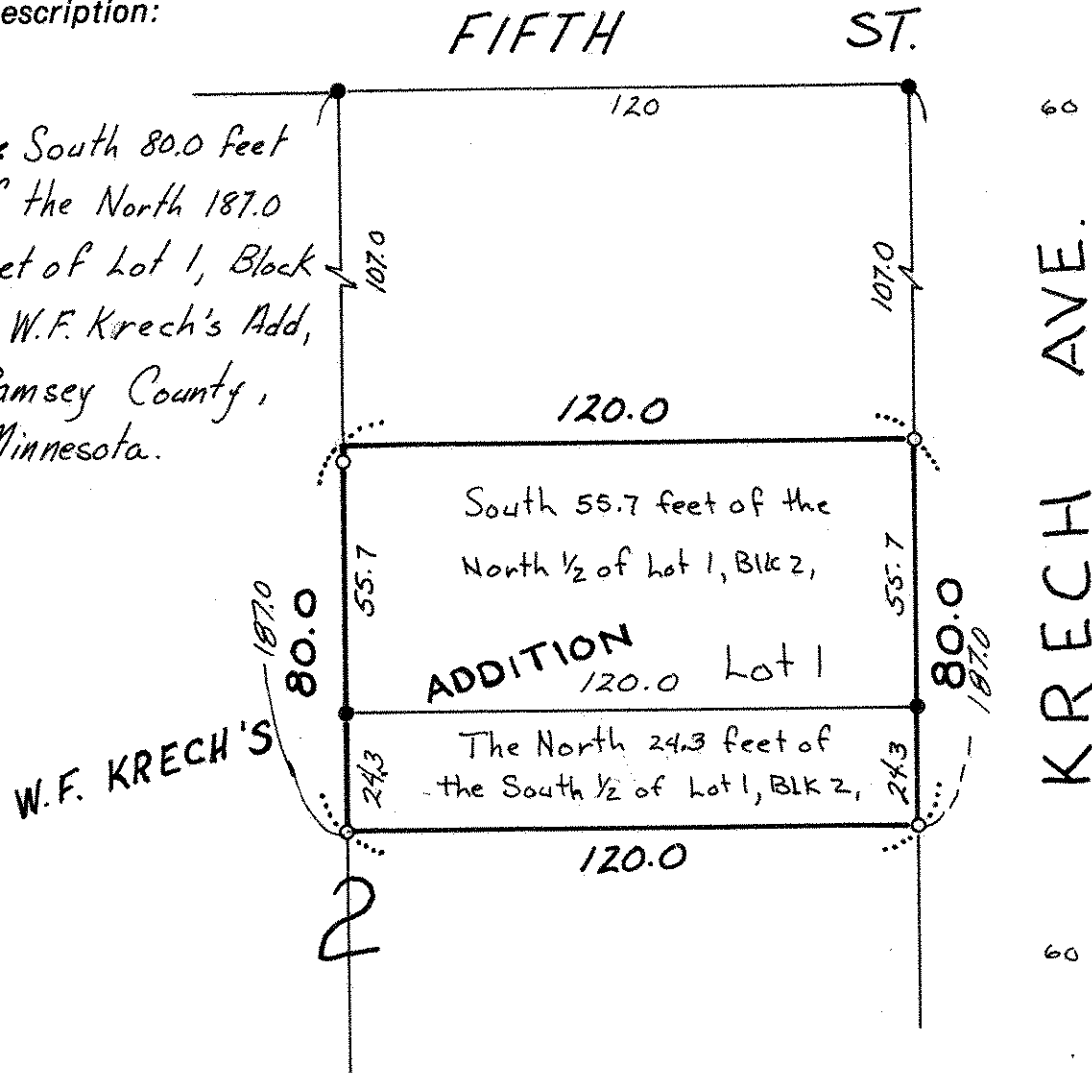

• Denotes iron
 pipe monument
 found in place
 o Denotes iron
 pipe monument