NW 25 30 22

Certificate of Survey

From the office of

GEORGI- SCHMIDT & ASSOC. INC.

3092 No. Lexington Ave., Roseville, Mn. 55113

LAND SURVEYING

483-4408

I Hereby Certify that this plat shows a survey made by me of the property described on this plat, and that the corners are correctly placed as shown, and that all locations have been correctly shown.

Job Number: 554

Surveyed For Eldon Morrison

Date 12/20/79

Scale 1"=50'

By Donald W. Schmidt
REGISTERED LAND SURVEYOR

Description:

Lot 3, Block 1, South Heights Addition
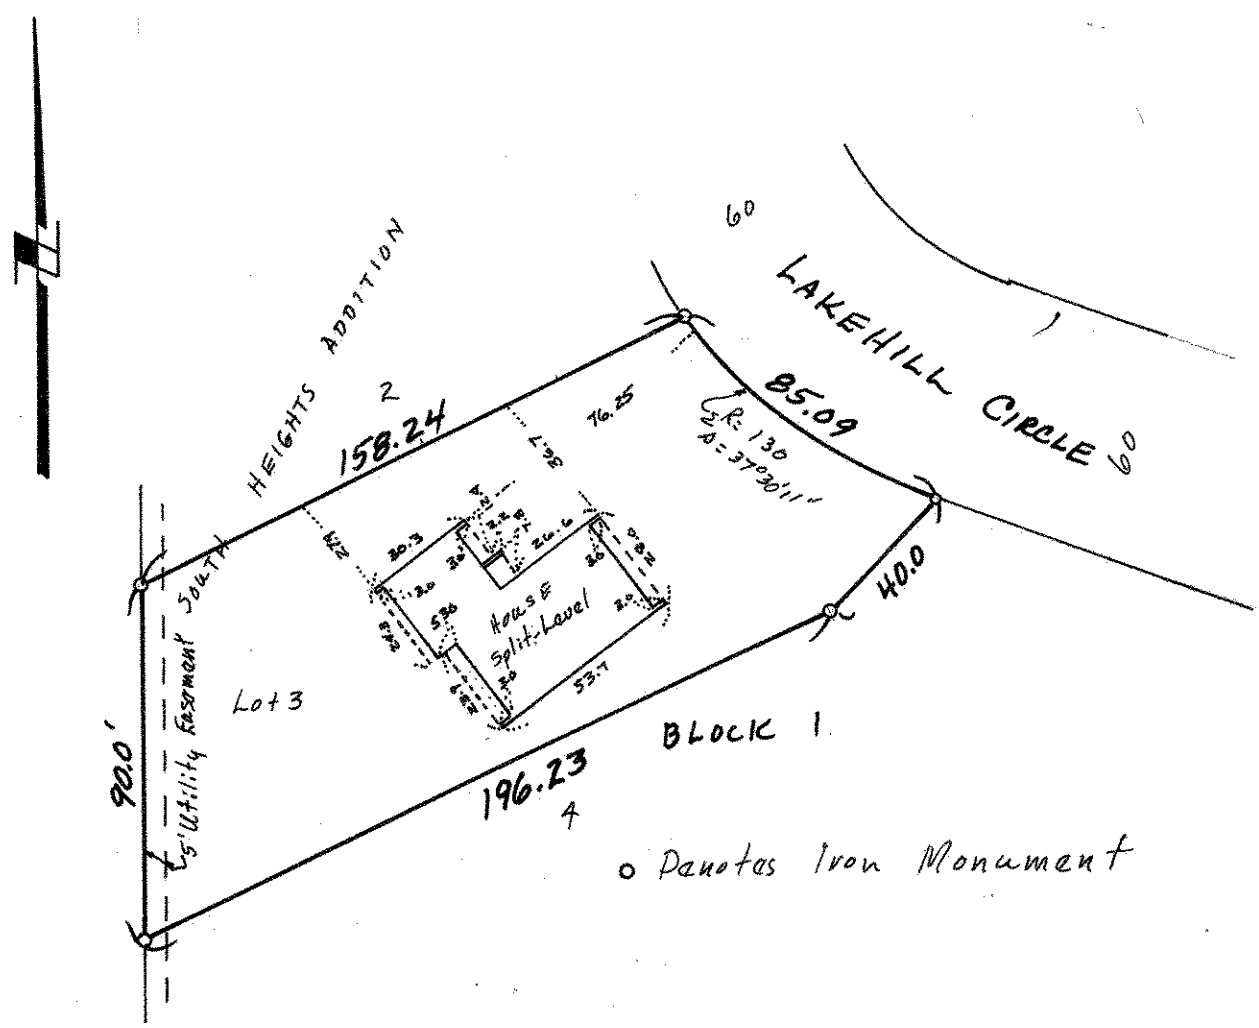
Ramsey County, Minnesota