

**Certificate
of Survey**

From the office of
GEORGI-SCHMIDT & ASSOC. INC.
 3092 No. Lexington Ave., Roseville, Mn. 55113
 LAND SURVEYING
 483-4408

I Hereby Certify that this plat shows a survey made by me of the property described on this plat, and that the corners are correctly placed as shown, and that all locations have been correctly shown.

Job Number: 10

Surveyed For Doris Mikeworth



Date July 17 1979

Scale 1" = 40'

By *Darold W. Schmidt*
 REGISTERED LAND SURVEYOR

Description:

Lot 1,
 Block 3,
 Mikeworth Addition,
 Ramsey County, Minnesota.

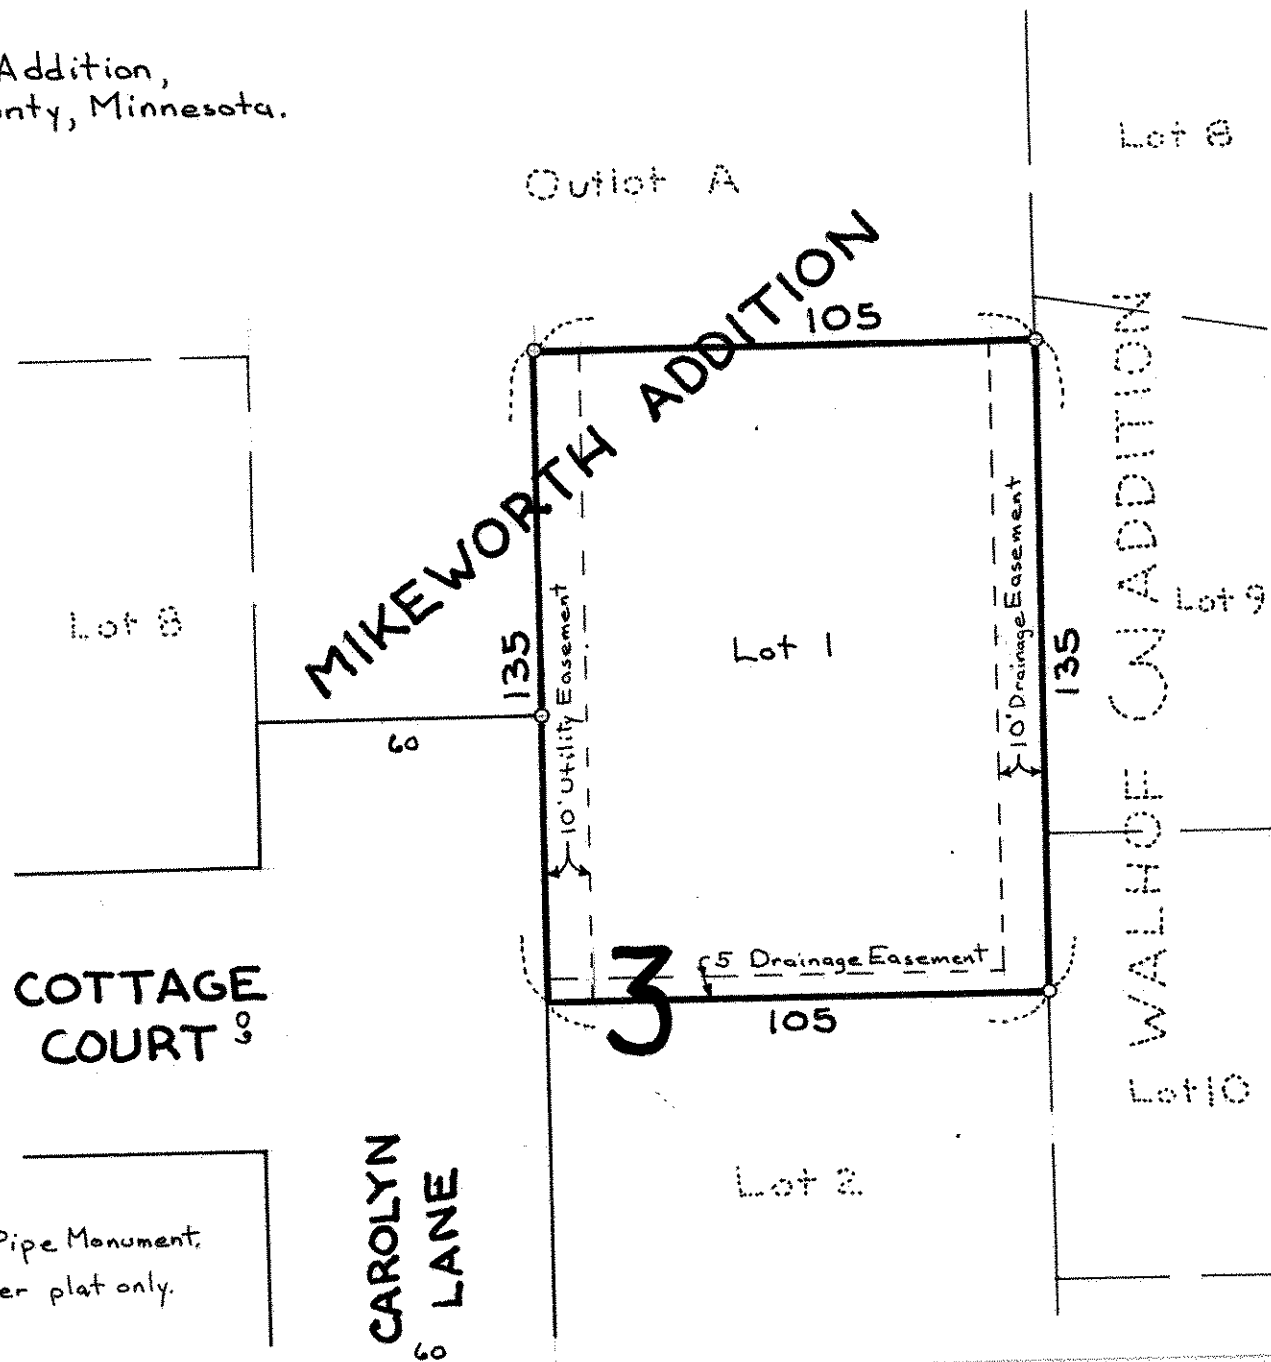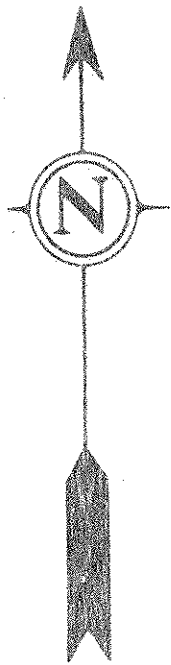

O Denotes Iron Pipe Monument.
 Easements as per plat only.