

**Certificate
of Survey**

From the office of
GEORGI-SCHMIDT & ASSOC. INC.
3092 No. Lexington Ave., Roseville, Mn. 55113
LAND SURVEYING
483-4408

I Hereby Certify that this plat shows a survey made by me of the property described on this plat, and that the corners are correctly placed as shown, and that all locations have been correctly shown.

Job Number: 10

Surveyed For Doris Mikeworth


Date July 16, 1979

Scale 1"=40'


By *Ronald W. Schmidt*
REGISTERED LAND SURVEYOR

Description:

Lot 6,
Block 2,
Mikeworth Addition,
Ramsey County, Minnesota.

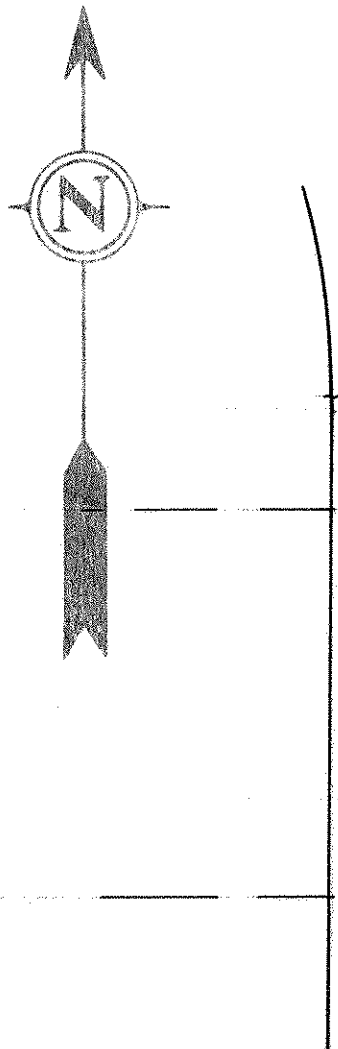

60 COTTAGE AVENUE 60

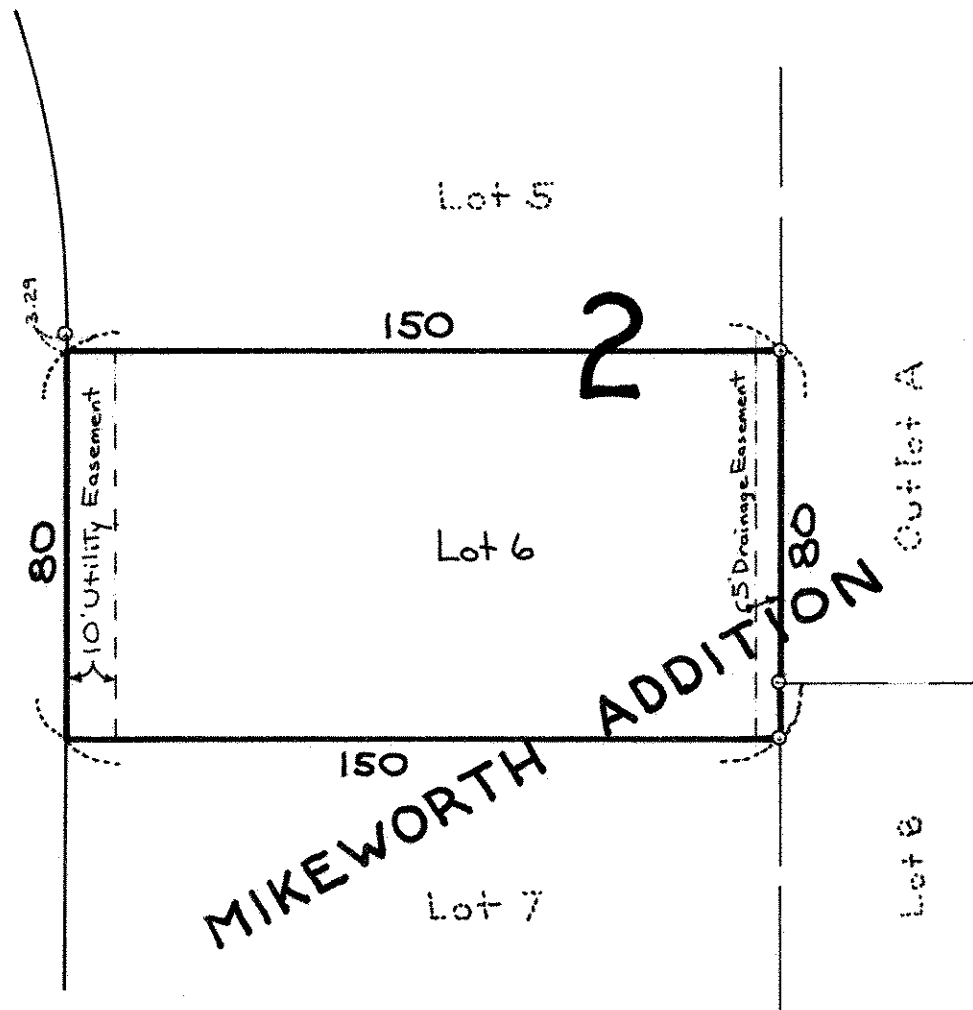

○ Denotes Iron Pipe Monument
Easements as per plat only