

Certificate of Survey

From the office of
GEORGI-SCHMIDT & ASSOC. INC.
3092 No. Lexington Ave., Roseville, Mn. 55113
LAND SURVEYING
483-4408

I Hereby Certify that this plat shows a survey made by me of the property described on this plat, and that the corners are correctly placed as shown, and that all locations have been correctly shown.

Job Number: 10

Surveyed For Doris Mikeworth

Date July 16, 1979



Scale 1" = 40'

By Ronald W. Schmid
REGISTERED LAND SURVEYOR

Description:

Lot 2,
Block 2,
Mikeworth Addition,
Ramsey County, Minnesota.

PROSPECT
AVENUE

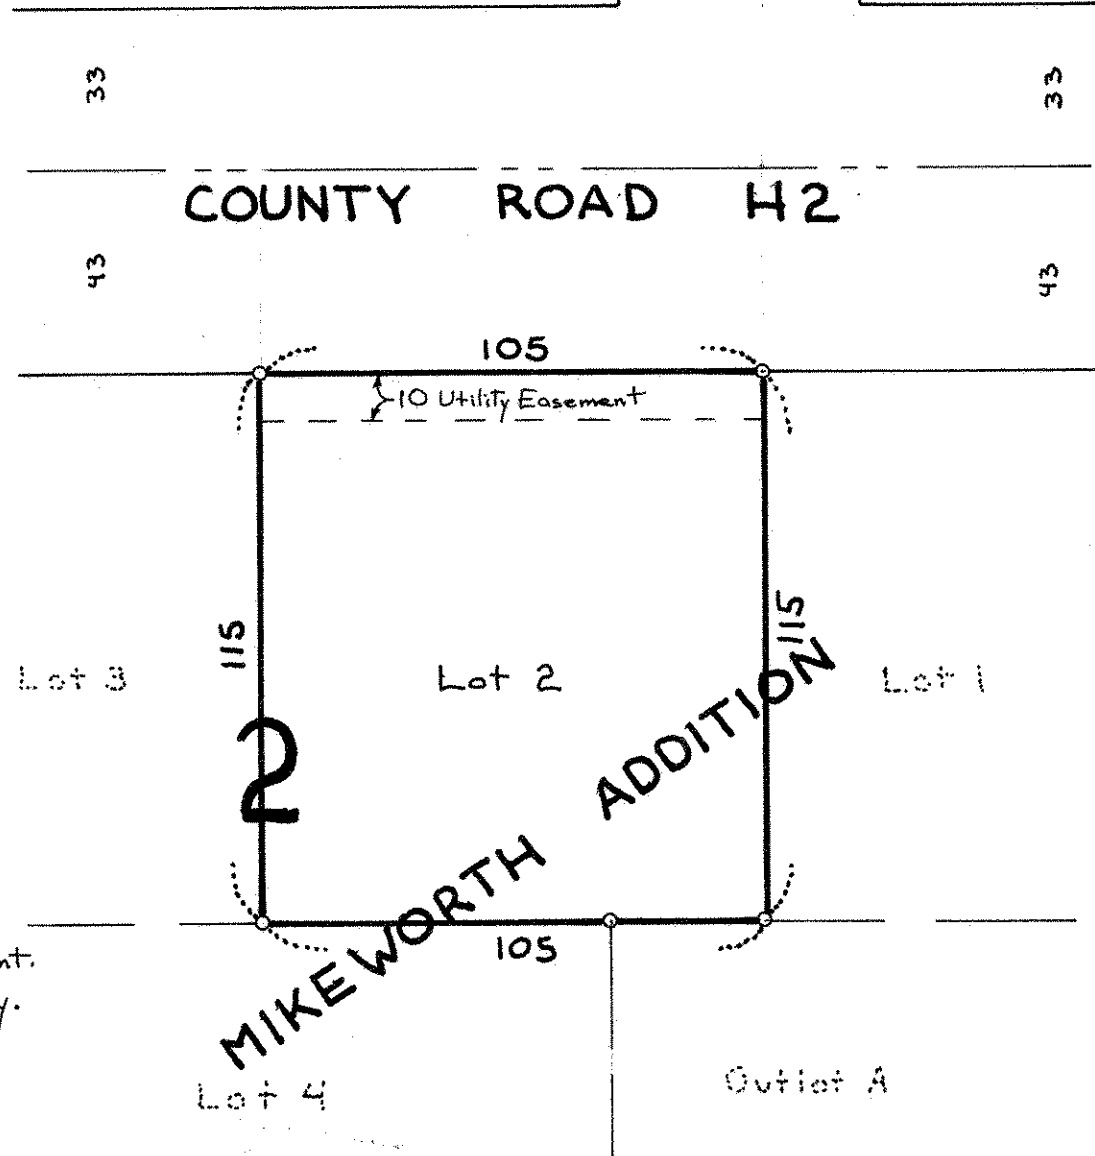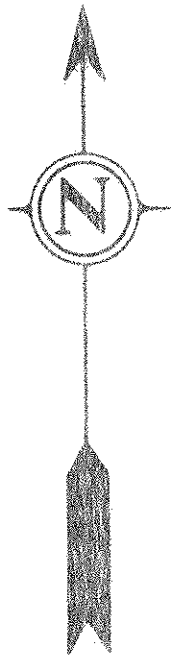

○ Denotes Iron Pipe Monument.
Easements as per plat only.