

SE 30 29 22

Certificate  
of Survey

From the office of  
**GEORGI-SCHMIDT & ASSOC. INC.**  
3092 No. Lexington Ave., Roseville, Mn. 55113  
LAND SURVEYING  
483-4408

I Hereby Certify that this plat shows a survey made by me of the property described on this plat, and that the corners are correctly placed as shown, and that all locations have been correctly shown.

Job Number: 499

Surveyed For FRANK MIKUTOWSKI

Date Oct. 1979


Scale 1" = 40'

By Donald W. Schmidt  
REGISTERED LAND SURVEYOR

Description:

Lot A, Block 6  
EDMUND RICE'S 3<sup>RD</sup> ADDITION  
Ramsey County, Minnesota

60 YORK AVE. 60

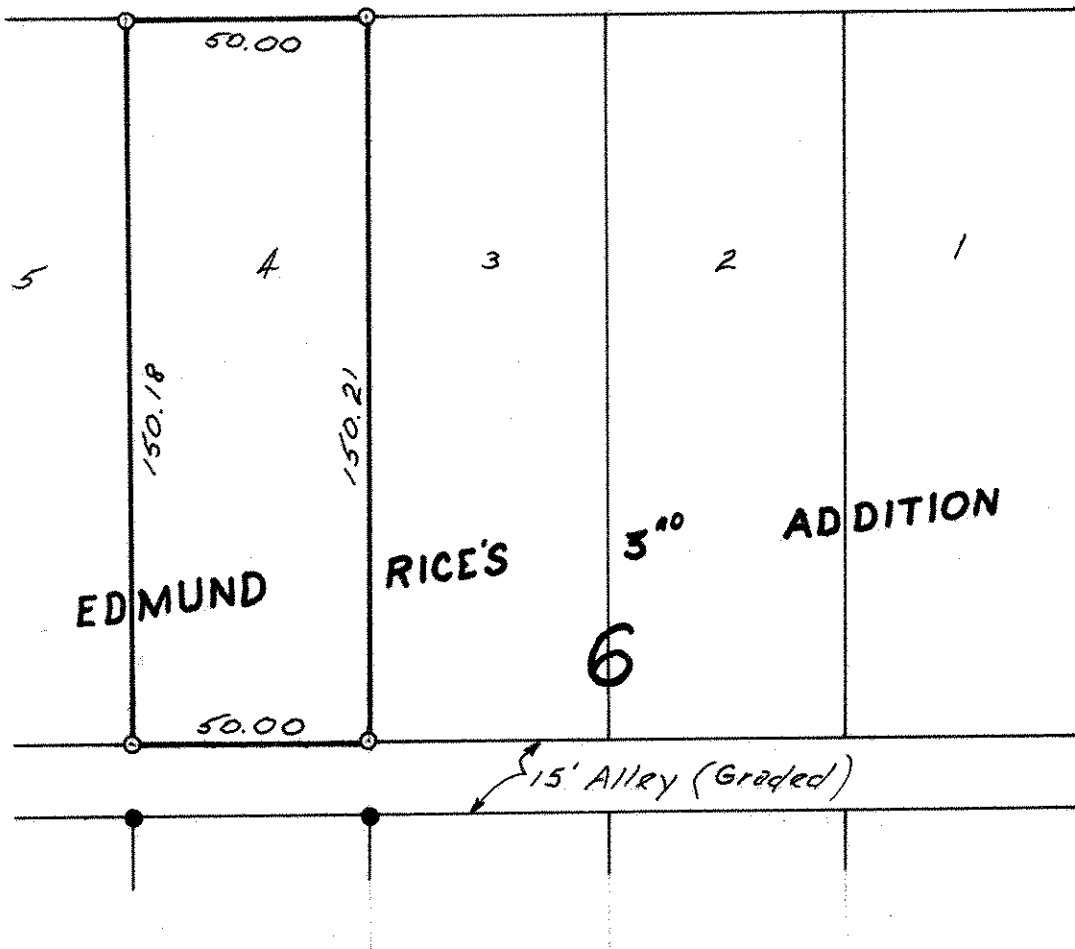

- Denotes Iron Monument Set
- Denotes Iron Monument Found