SE 30 29 22

Certificate of Survey

From the office of
GEORGI- SCHMIDT & ASSOC. INC.
3092 No. Lexington Ave., Roseville, Mn. 55113
LAND SURVEYING
483-4408

I Hereby Certify that this plat shows a survey made by me of the property described on this plat, and that the corners are correctly placed as shown, and that all locations have been correctly shown.

Job Number: 338

Surveyed For St. Paul Structural Steel

Date May 1979

Scale 1"=40'

By Donald W. Schmidt
REGISTERED LAND SURVEYOR

Description:

Line between Lot 12 & Lot 13, Auditor's Subdivision No. 8

Ramsey County, Minn.

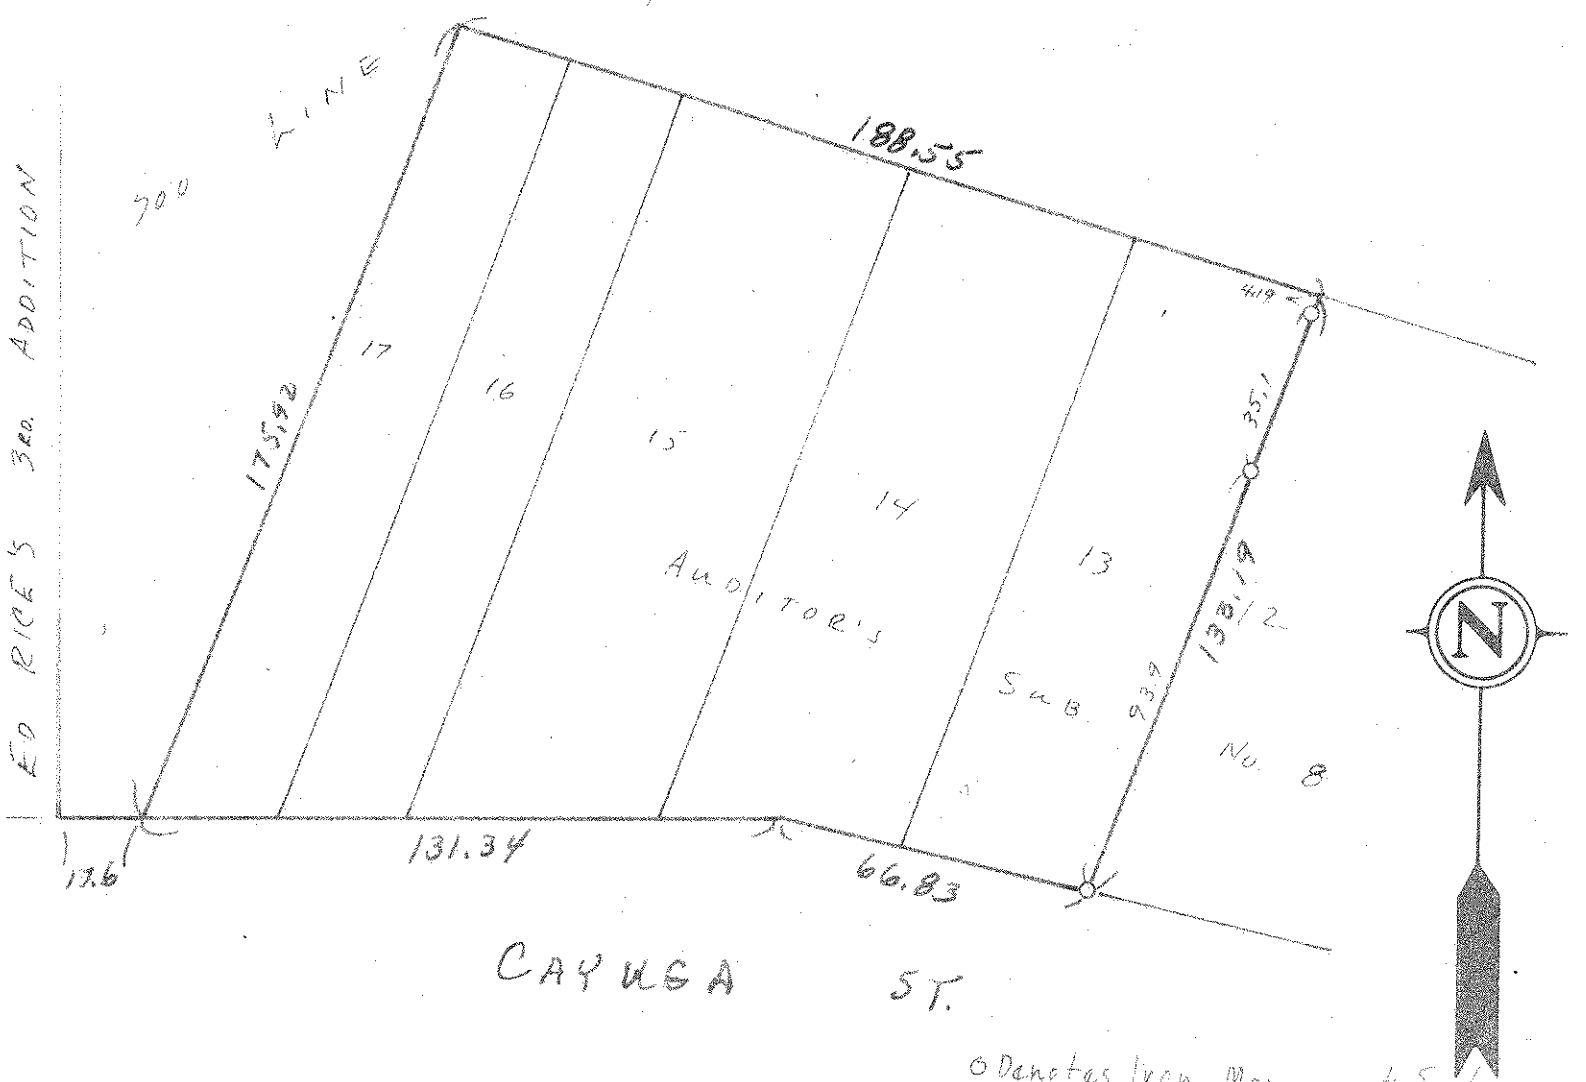

⊙ Denotes Iron Monument Set