


PHONE 735-4343

1903 E. MINNEHAHA AVE.
ST. PAUL, MN. 55119

WARREN I. FORSBERG, REGISTERED LAND SURVEYOR
DBA

LAKE & LAND SURVEYING CO.

SURVEY FOR CLARENCE SEIDEL
Lots 27, 28, 29 and 30, Block 21, A. Gotzians Rearrangement

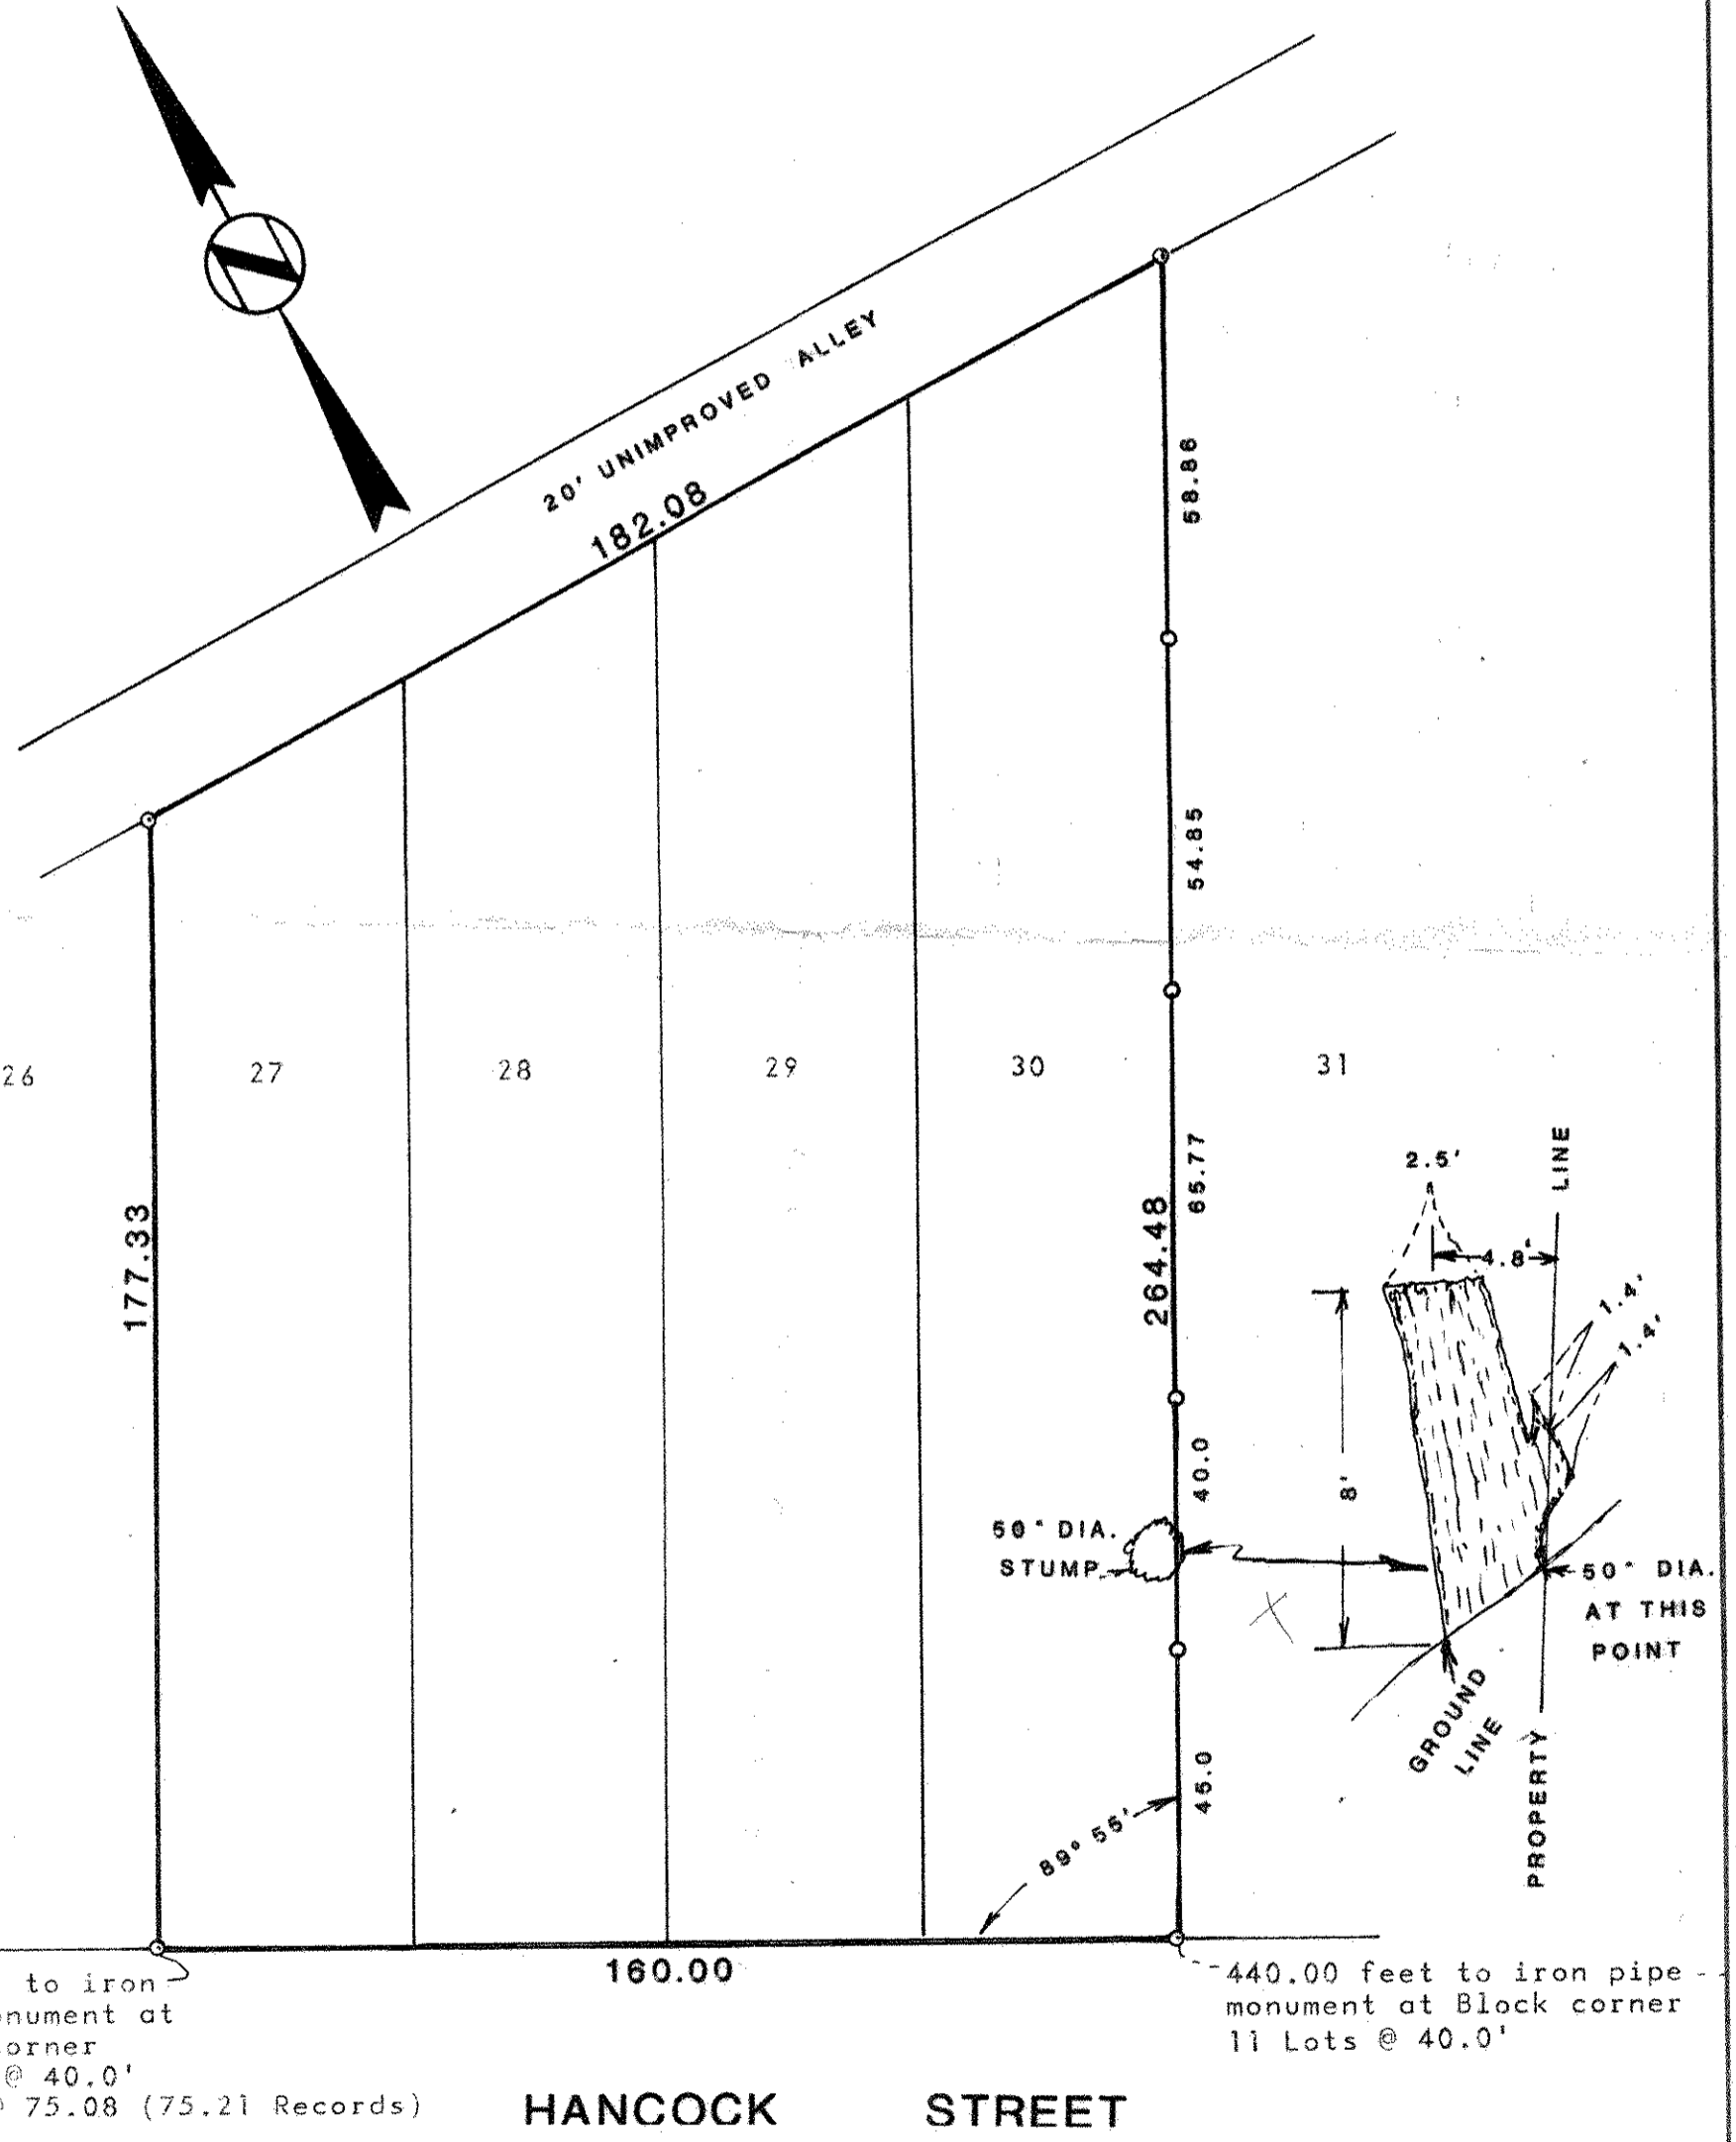

315.08' to iron pipe monument at Block corner
6 Lots @ 40.0'
1 Lot @ 75.08 (75.21 Records)

440.00 feet to iron pipe monument at Block corner
11 Lots @ 40.0'

HANCOCK STREET

I HEREBY CERTIFY THAT THIS SURVEY WAS PREPARED BY ME OR UNDER MY DIRECT SUPERVISION AND THAT I AM A DULY REGISTERED LAND SURVEYOR UNDER THE LAWS OF THE STATE OF MINNESOTA.

SIGNED Warren I. Forsberg
DATE May 22, 1979

REGISTRATION NO. 4840 MINN. & S-1162 WISC.

SCALE 1 INCH = 30 FEET
O - INDICATES IRON MONUMENT SET
● - INDICATES IRON MONUMENT FOUND