

SW 8 27 25

Certificate of Survey

From the office of
GEORGI-SCHMIDT & ASSOC. INC.
3092 No. Lexington Ave., Roseville, Mn. 55113
LAND SURVEYING
483-4408

I Hereby Certify that this plat shows a survey made by me of the property described on this plat, and that the corners are correctly placed as shown, and that all locations have been correctly shown.

Job Number: 788

Surveyed For Bruce Berg


Date Nov. 1980

Scale 1" = 50'

By Donald W. Schmidt
REGISTERED LAND SURVEYOR

Description:

South 70 feet of North 440 feet
of East 297 feet, of N.E. of S.W. Sec. 8-129A23
Ramsey County, Minn. except East 33 feet

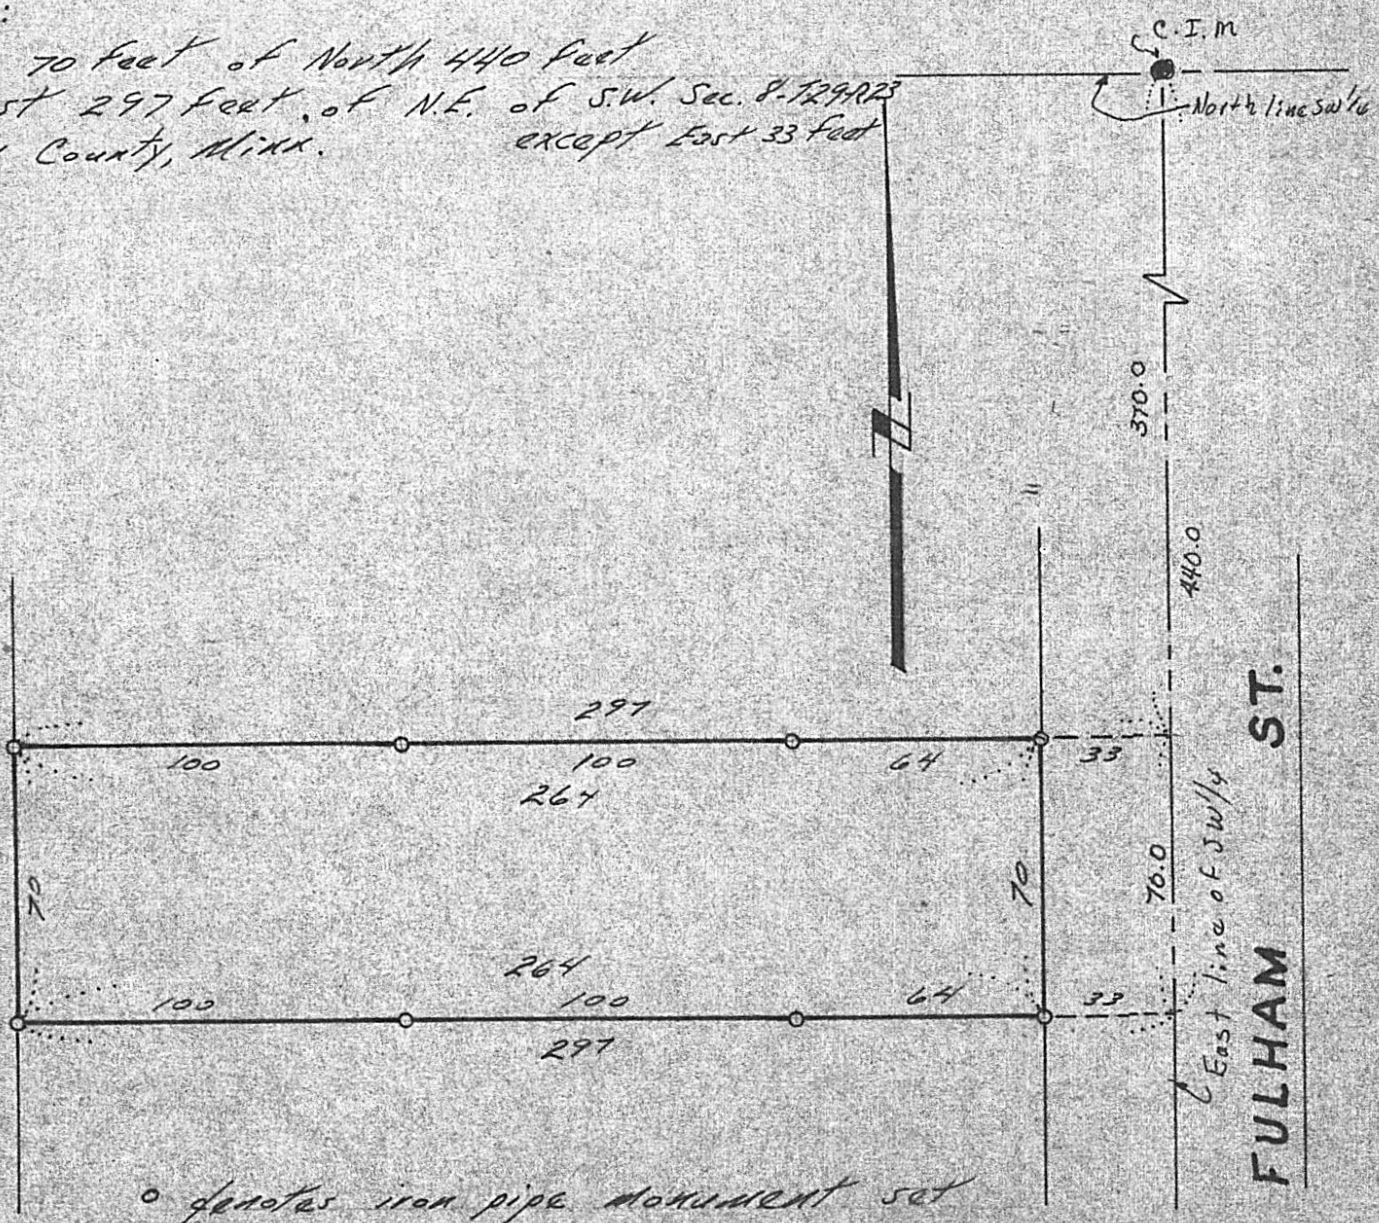

o denotes iron pipe monument set