NW 11 30 23

Certificate of Survey

From the office of

GEORGI- SCHMIDT & ASSOC. INC.

3092 No. Lexington Ave., Roseville, Mn. 55113

LAND SURVEYING

483-4408

I Hereby Certify that this plat shows a survey made by me of the property described on this plat, ~~and that the corners are correctly placed as shown~~, and that all locations have been correctly shown.

Job Number: _____

Surveyed For John Sauro

Date Aug. 1980

Scale 1" = 40'

By Donald W. Schmidt

REGISTERED LAND SURVEYOR

Description:
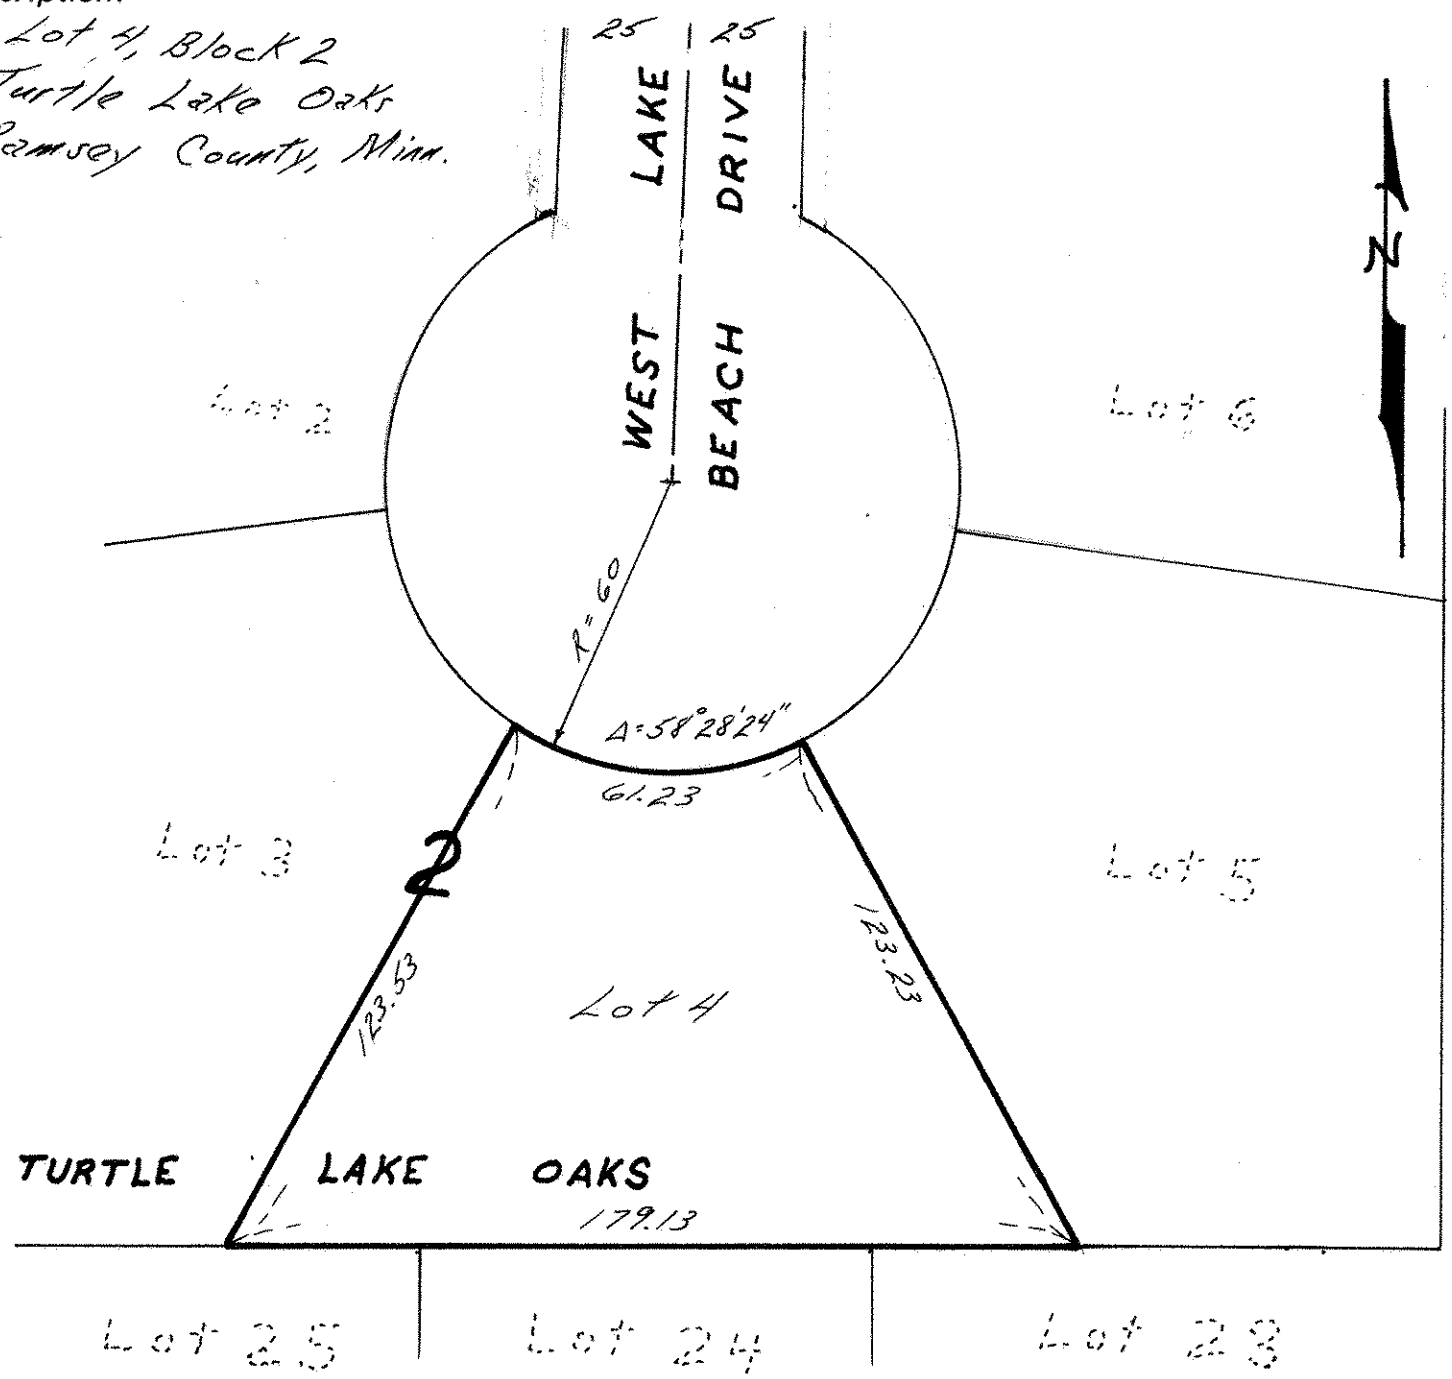
Lot 4, Block 2
Turtle Lake Oaks
Ramsey County, Minn.