

54 11 30 22

# Certificate of Survey

From the office of  
**GEORGI-SCHMIDT & ASSOC. INC.**  
3092 No. Lexington Ave., Roseville, Mn. 55113  
LAND SURVEYING  
483-4408

I Hereby Certify that this plat shows a survey made by me of the property described on this plat, and that the corners are correctly placed as shown, and that all locations have been correctly shown.

Job Number: 658

Surveyed For CHUCK MOORE


Date JUNE 1980

Scale 1" = 50'

By Ronald W. Schmidt  
REGISTERED LAND SURVEYOR

Description:

Lot 17, Block 7  
BALD EAGLE  
RAMSEY COUNTY, MN.

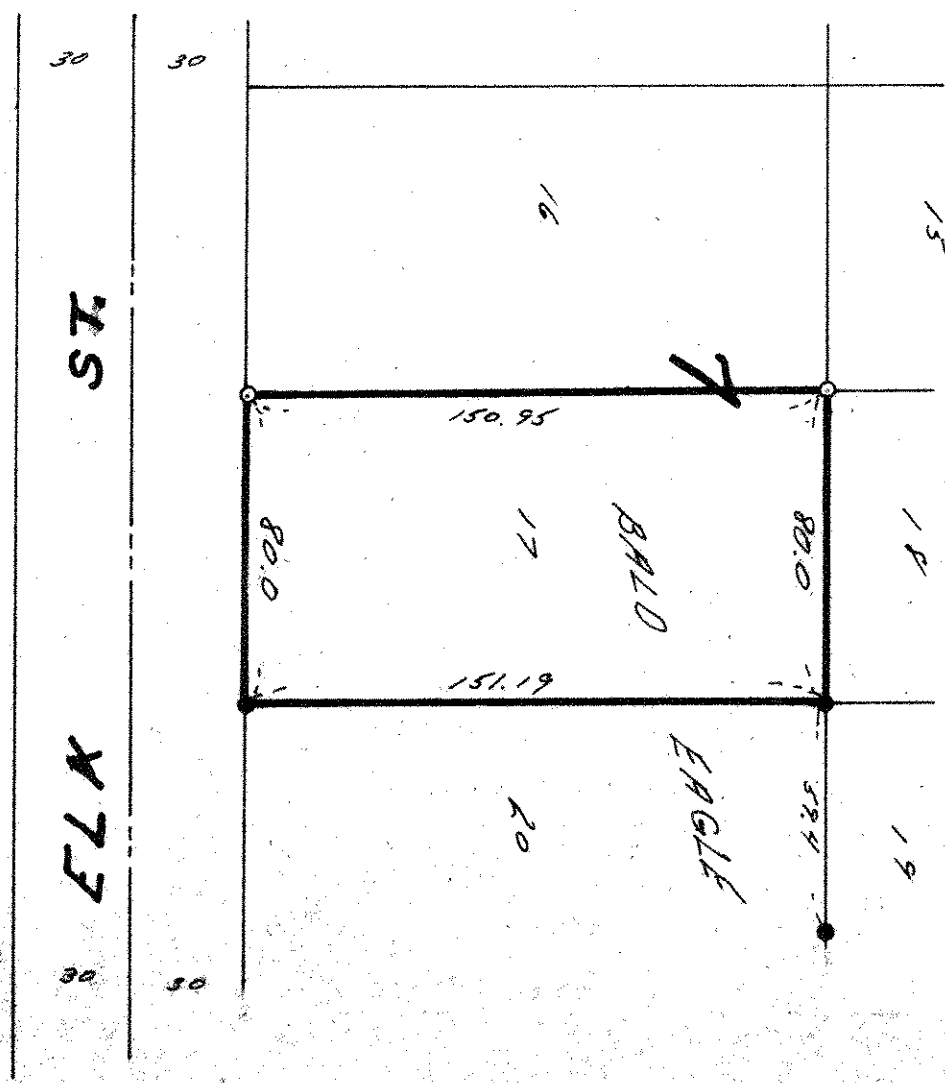

- denotes iron pipe monument found
- denotes iron pipe monument set