

**Certificate
of Survey**

From the office of
GEORGI-SCHMIDT & ASSOC. INC.
3092 No. Lexington Ave., Roseville, Mn. 55113
LAND SURVEYING
483-4408

I Hereby Certify that this plat shows a survey made by me of the property described on this plat, and that the corners are correctly placed as shown, and that all locations have been correctly shown.

Job Number: 595

Surveyed For Thomas Fitzpatrick

Date May 1980


Scale 1"=100'

By Donald W. Schmidt
REGISTERED LAND SURVEYOR

Description:

Except the South 290 feet, the South 1/2 of Lot 14, Elmwood Garden Farms No. 2, except the West 30 feet and except the South 145.6 feet of the East 50 feet thereof. Together with a roadway easement over the West 30 feet of said South 1/2 of Lot 14.

Ramsey County, Minnesota

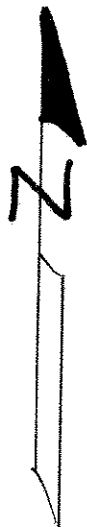

- Denotes Iron Monument Set
- Denotes Iron Found in place

