SE 9 29 22

Certificate of Survey

From the office of

GEORGI- SCHMIDT & ASSOC. INC.

3092 No. Lexington Ave., Roseville, Mn. 55113

LAND SURVEYING

483-4408

I Hereby Certify that this plat shows a survey made by me of the property described on this plat, and that the corners are correctly placed as shown, and that all locations have been correctly shown.

Job Number: 743

Surveyed For Bernhart Const.

Date September 15, 1980

Scale 1" = 40'

By Donald W. Schmidt

REGISTERED LAND SURVEYOR

Description:
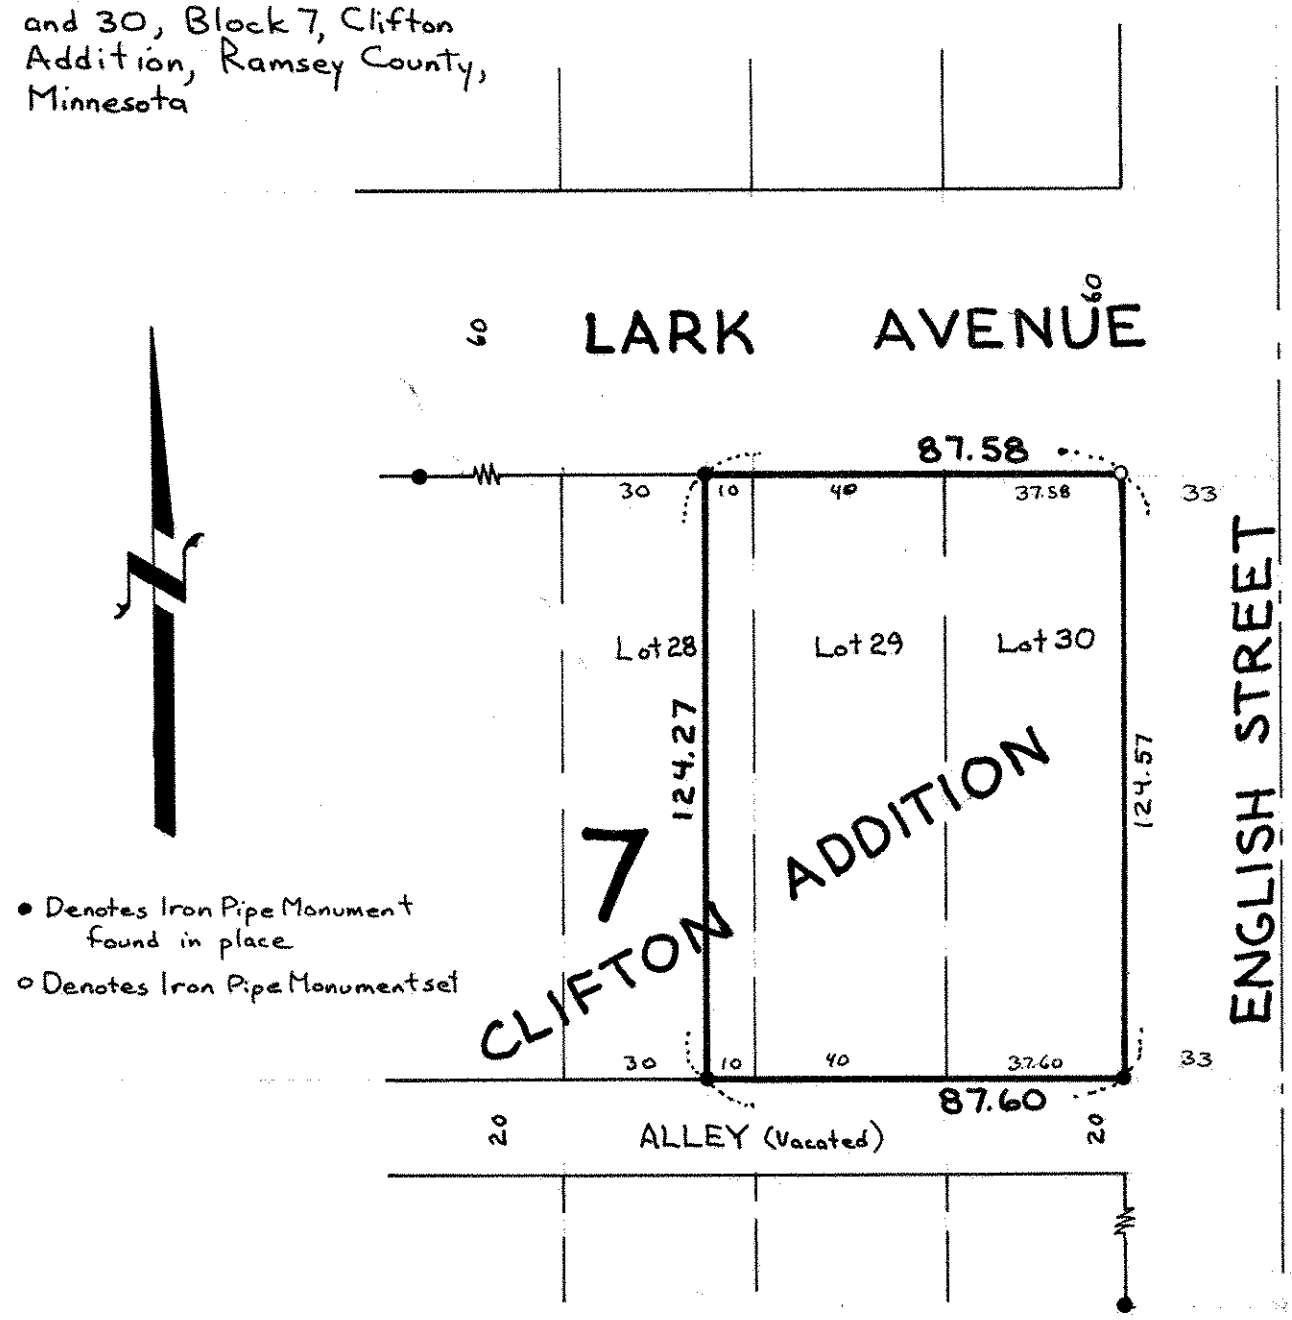
Lot 28 except the West 30 feet and all of Lots 29 and 30, Block 7, Clifton Addition, Ramsey County, Minnesota