

Certificate
of Survey

From the office of
GEORGI-SCHMIDT & ASSOC. INC.
3092 No. Lexington Ave., Roseville, Mn. 55113
LAND SURVEYING
483-4408

I Hereby Certify that this plat shows a survey made by me of the property described on this plat, and that the corners are correctly placed as shown, and that all locations have been correctly shown.

Job Number: 822

Surveyed For Sonnen


Date Dec. 12, 1980

Scale 1" = 40'

By Donald W. Schmeckel
REGISTERED LAND SURVEYOR

Description:

Lot 8,
Block 1,
Ridgewind,
Ramsey County,
Minnesota.

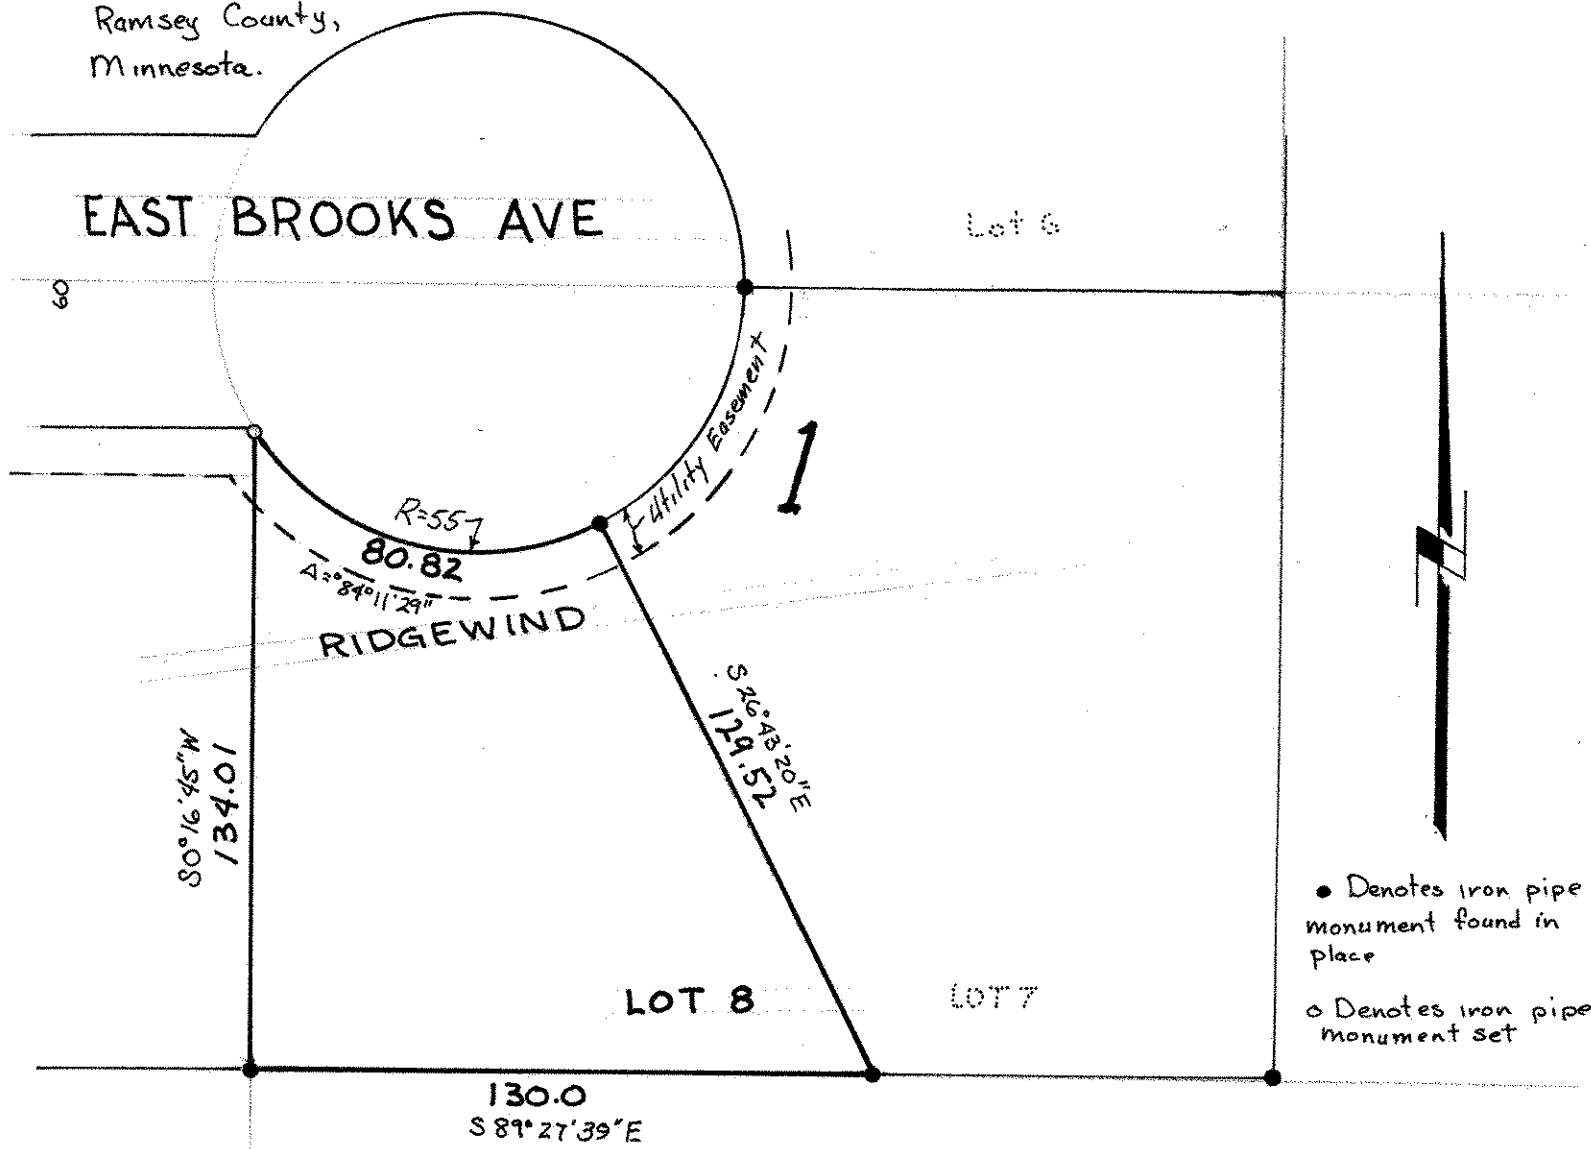

● Denotes iron pipe monument found in place

○ Denotes iron pipe monument set