SE 11 29 22

Certificate of Survey

From the office of

GEORGI- SCHMIDT & ASSOC. INC.

3092 No. Lexington Ave., Roseville, Mn. 55113

LAND SURVEYING

483-4408

I Hereby Certify that this plat shows a survey made by me of the property described on this plat, and that the corners are correctly placed as shown, and that all locations have been correctly shown.

Job Number: 738

Surveyed For Bernhart Const.

Date 9/15/80

Scale 1" = 40'

By Gerald W. Schmidt
REGISTERED LAND SURVEYOR

Description:

Lot 17, Auditor's Subdivision No. 86
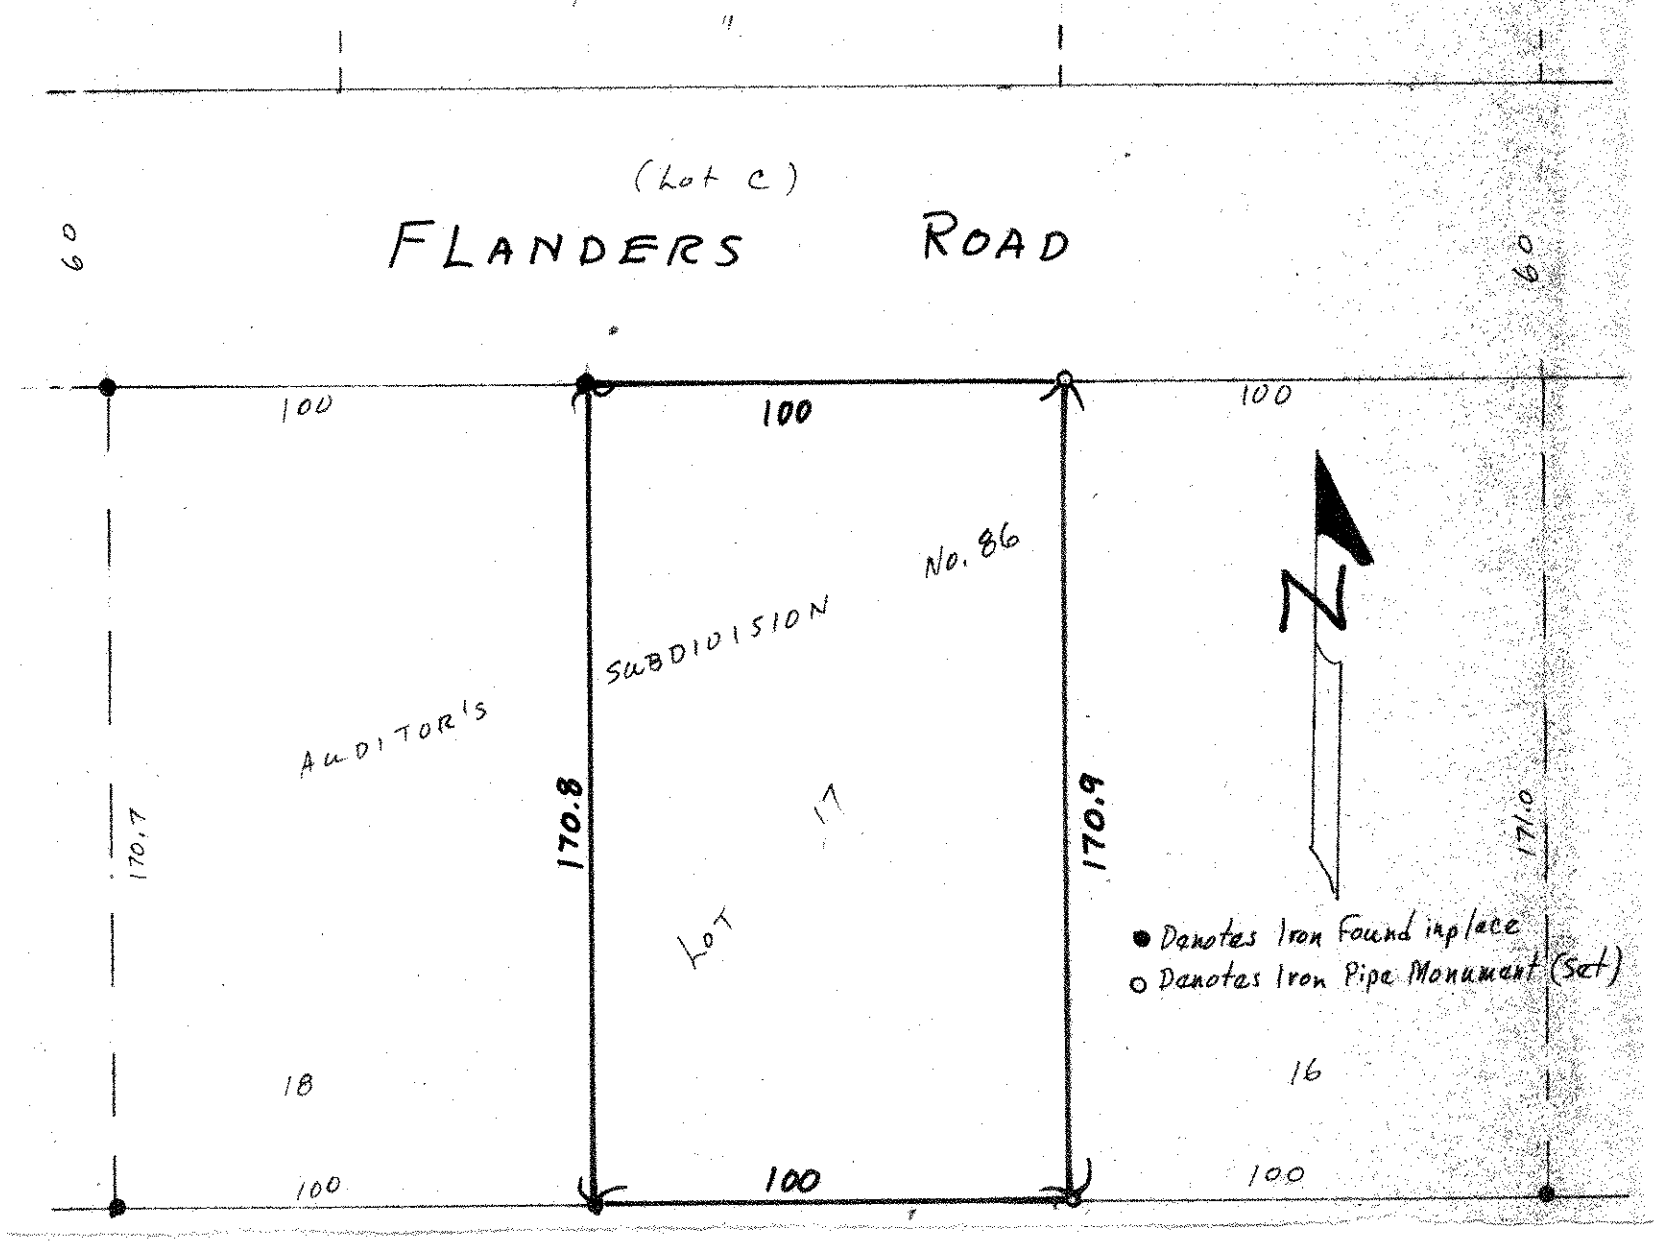
Ramsey County, Minnesota