NE 3 29 23

Certificate of Survey

From the office of

GEORGI- SCHMIDT & ASSOC. INC.

3092 No. Lexington Ave., Roseville, Mn. 55113

LAND SURVEYING

483-4408

I Hereby Certify that this plat shows a survey made by me of the property described on this plat, ~~and that the corners are correctly placed as shown~~, ~~and that all locations have been correctly shown.~~

Job Number: 1563

Surveyed For Belair Builders

Date December 29 1980 - 4/2/84

Scale 1" = 40'

By Donald W. Schmidt

REGISTERED LAND SURVEYOR

#10459

Description:

All of Lot 5 and that part of Lot 4, Block 1, Belair Lake Josephine Heights No. 2, lying Southwesterly of the following described line:

Beginning at the Northwesterly corner of said Lot 4; thence S 35°56'13"E 214.83 feet to a point on the Southeasterly line of said Lot 4 distant 22.36 feet Southwesterly along a curve from the Southeasterly corner of said Lot 4 and there terminating.

Ramsey County, Minn.

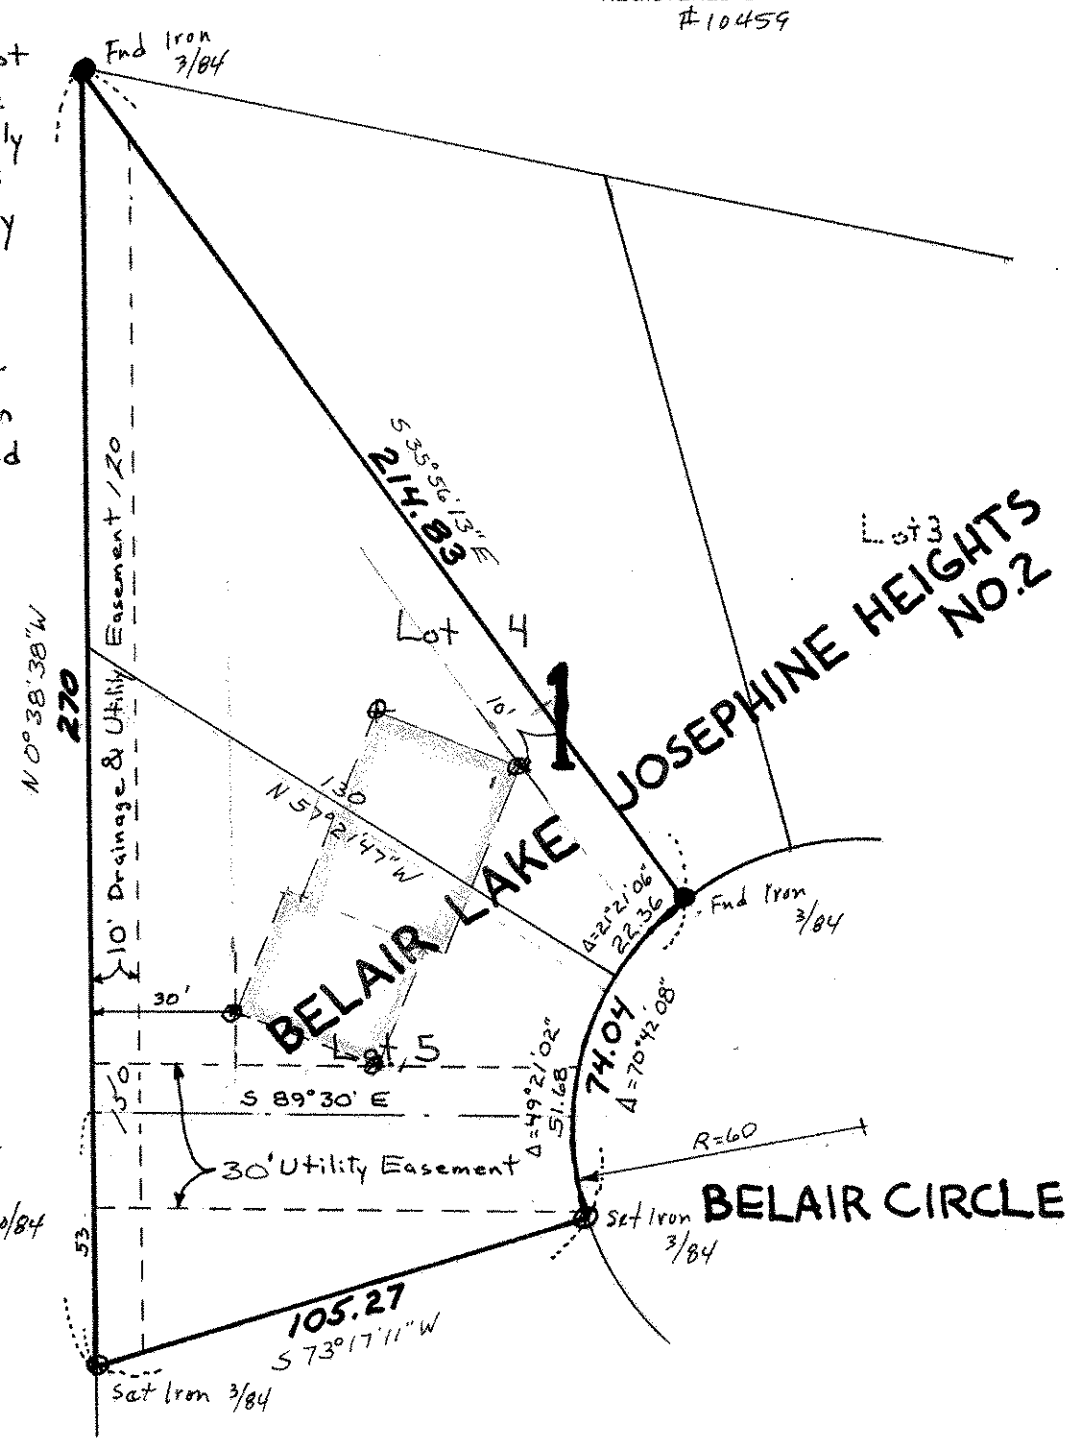

⊗ Spk Set 2 House Corners &
2 Garage Corners 3/30/84

Easements as per plat only.