SE 27 29 23

Certificate of Survey

From the office of

GEORGI- SCHMIDT & ASSOC. INC.

3092 No. Lexington Ave., Roseville, Mn. 55113

LAND SURVEYING

483-4408

I Hereby Certify that this plat shows a survey made by me of the property described on this plat, and that the corners are correctly placed as shown, and that all locations have been correctly shown.

Job Number: 657

Surveyed For Phil Ryahner

Date 6/6/80

Scale 1"=40'

By Ernald W. Schmidt

REGISTERED LAND SURVEYOR

Description:

Lot 30, Block 5, Hersey-Woolsey Addition, except the North 8.0 Feet thereof taken for alley.
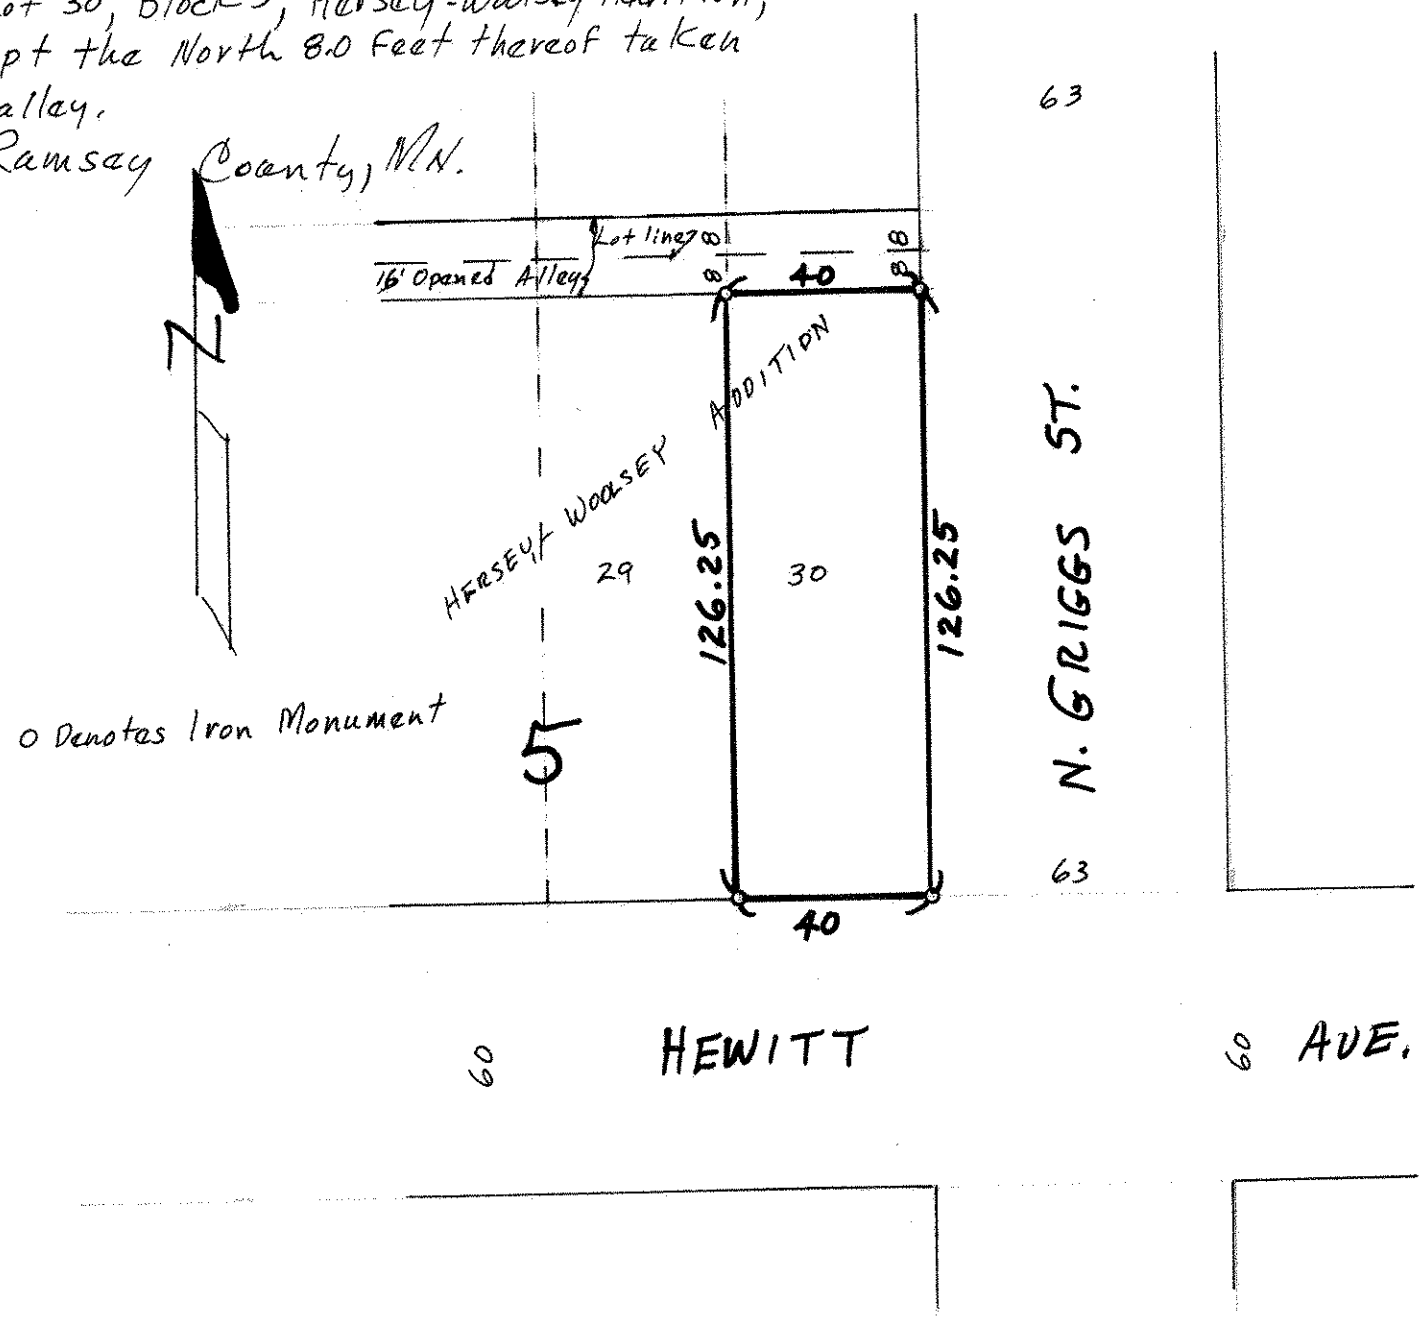
Ramsey County, MN.