NE 35 29 23

Certificate of Survey

From the office of

GEORGI- SCHMIDT & ASSOC. INC.

3092 No. Lexington Ave., Roseville, Mn. 55113

LAND SURVEYING

483-4408

I Hereby Certify that this plat shows a survey made by me of the property described on this plat, and that the corners are correctly placed as shown, and that all locations have been correctly shown.

Job Number: 680

Surveyed For Francis Carpenter

Date July 2, 1980

Scale 1"=30'

By Donald W. Schmidt

REGISTERED LAND SURVEYOR

Description:
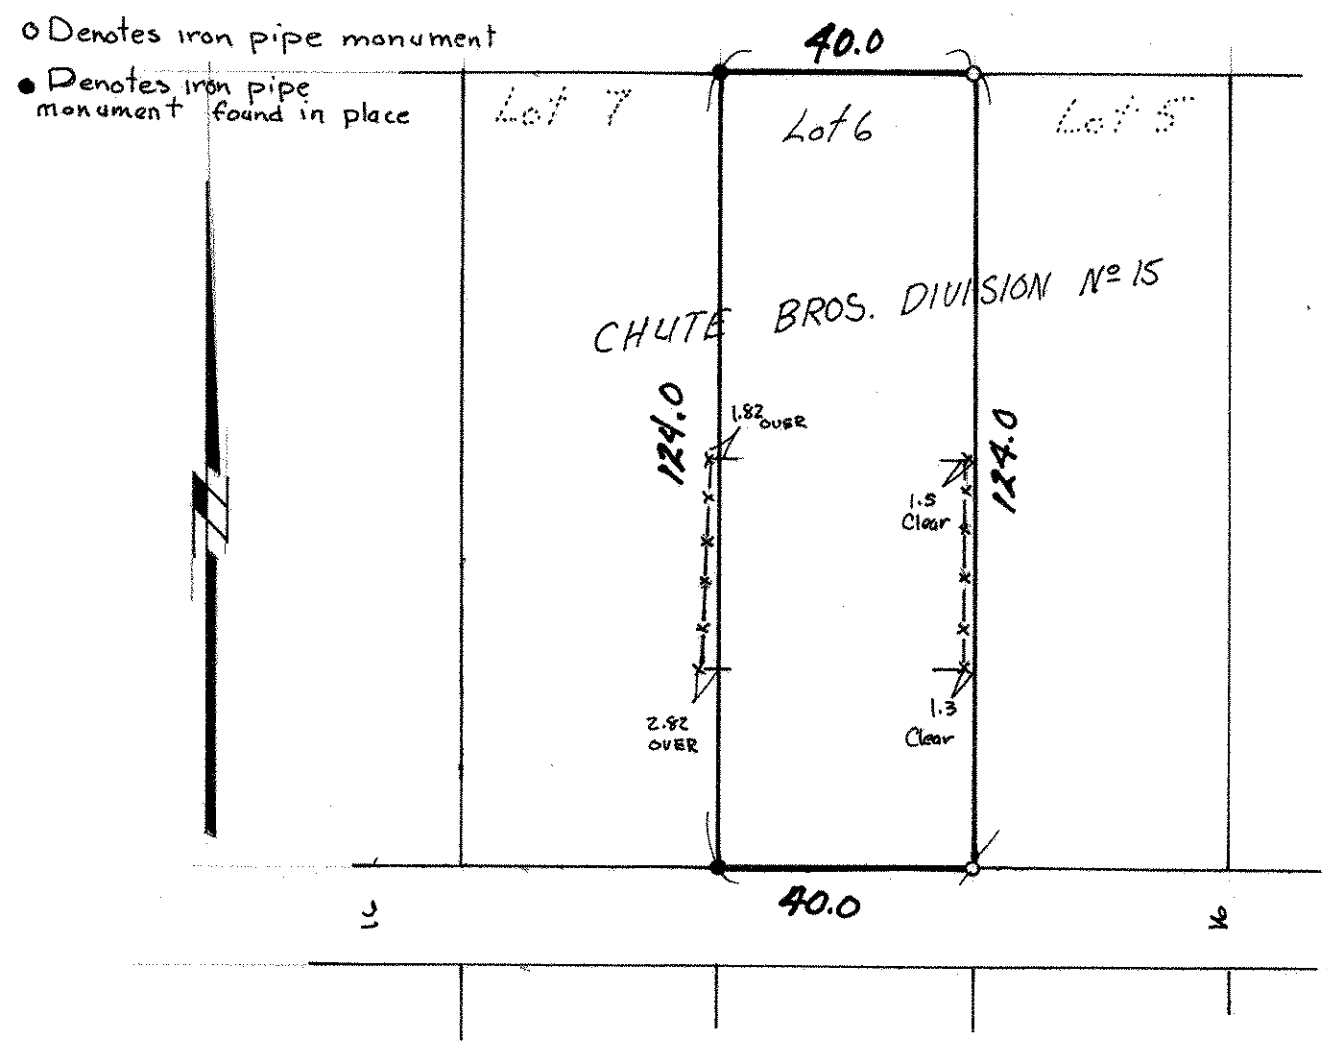
Lot 6,
Chute Bros. Division No. 15,
Ramsey County,
Minnesota.